

STATE ENGINEER
Salem, Oregon

Well Record **LANE**
019507

STATE WELL NO. 19/1W-6H(1)
COUNTY Lane
APPLICATION NO. GR-433

OWNER: Glenn & Dale Beamer


MAILING ADDRESS: _____

LOCATION OF WELL: Owner's No. _____

CITY AND STATE: Eugene, Oregon

SE 1/4 NE 1/4 Sec. 6 T. 19 N. S., R. 1 E. W., W.M.

Bearing and distance from section or subdivision
corner 1080 ft. W. & 75 ft. N. from E 1/4 cor. Sec. 6

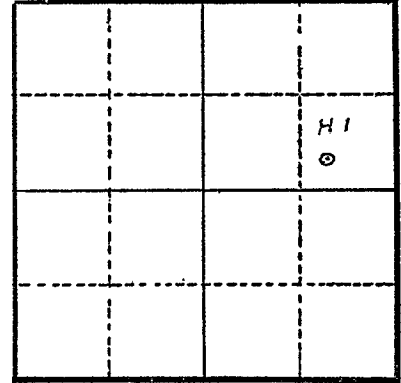

Section 6

Altitude at well _____

TYPE OF WELL: dug Date Constructed 1943

Depth drilled 14 Depth cased 14

CASING RECORD: 48 inch hole
48 inch casing of 2 in. planking

FINISH:

AQUIFERS:

WATER LEVEL: 10 ft.

PUMPING EQUIPMENT: Type Deming 2 1/2 in. x 3 1/2 in. H.P. 10
Capacity 220 G.P.M.

WELL TESTS:
Drawdown 3 ft. after _____ hours 238 G.P.M.
Drawdown _____ ft. after _____ hours _____ G.P.M.

USE OF WATER irrigation 28 acres Temp. _____ °F., 19

SOURCE OF INFORMATION GR-433

DRILLER or DIGGER _____

ADDITIONAL DATA:
Log Water Level Measurements _____ Chemical Analysis _____ Aquifer Test _____

REMARKS: Log: Chehalis loam soil with gravel mixed in to depth of 14 ft.