

STATE ENGINEER
Salem, Oregon

Well Record LANE

STATE WELL NO. 19/1W-6L(1)
COUNTY Lane
APPLICATION NO. GR-344

019508

OWNER: W. G. Edson

MAILING ADDRESS: Star Route


LOCATION OF WELL: Owner's No. 1

CITY AND STATE: Dexter, Oregon

NE 1/4 SW 1/4 Sec. 6 T. 19 S., R. 1 E. W., W.M.

Bearing and distance from section or subdivision
corner N. 13+ 16' W. 1679.9 ft. from NE cor.

Henry Morgan DIC 37

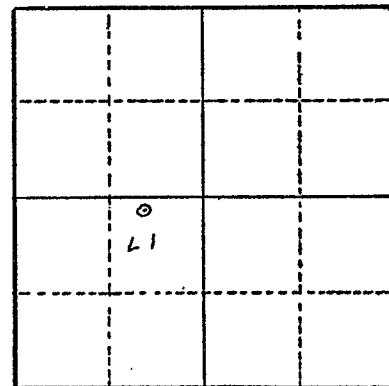

Altitude at well 450 ft. Interpolated

TYPE OF WELL: drilled Date Constructed April 1953

Depth drilled 45 ft. Depth cased 40 ft.

Section 6

CASING RECORD: 6 inch casing set from 0 to 40 ft.

FINISH: unknown

AQUIFERS: unknown

WATER LEVEL: 8 ft. below land surface

PUMPING EQUIPMENT: Type Fairbanks Morse jet H.P. 2
Capacity 20 G.P.M.

WELL TESTS:
Drawdown ft. after hours G.P.M.
Drawdown ft. after hours G.P.M.

USE OF WATER irrigation 2.2 acres Temp. °F. 19

SOURCE OF INFORMATION Reg. St. GR-344

DRILLER or DIGGER unknown

ADDITIONAL DATA:
Log Water Level Measurements Chemical Analysis Aquifer Test

REMARKS: