

STATE ENGINEER
Salem, Oregon

LANE
019905 Well Record

STATE WELL NO. 19/2W-1D
COUNTY Lane
APPLICATION NO. GR-3758

OWNER: Lionel E. Wertman

MAILING

ADDRESS: Route 2, Box 690

LOCATION OF WELL: Owner's No.


CITY AND

STATE: Creswell, Oregon

NW 1/4 NW 1/4 Sec. 1 T. 19 N. S. R. 2 E. W., W.M.

Bearing and distance from section or subdivision

corner S. 10° 12' 30" E. 632 ft. from NW Cor. Sec. 1

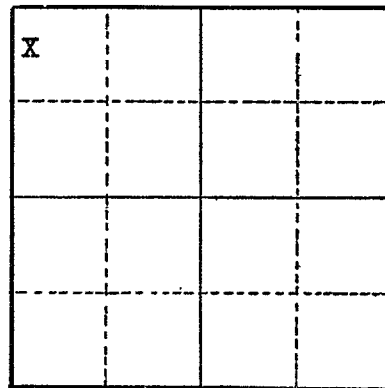

Altitude at well

TYPE OF WELL: Drilled Date Constructed Sept., 1947

Depth drilled 110 feet Depth cased

Section 1

CASING RECORD:

FINISH:

AQUIFERS:

WATER LEVEL:

17 feet below surface

PUMPING EQUIPMENT: Type Berkley Jet centrifugal H.P. 1
Capacity 25 G.P.M.

WELL TESTS:

Drawdown 12 ft. after 28 hours G.P.M.

Drawdown 14 ft. after 30 hours G.P.M.

USE OF WATER Irrigation Temp. °F. 19

SOURCE OF INFORMATION Well Registration Statement

DRILLER or DIGGER H. E. Jones

ADDITIONAL DATA:

Log Water Level Measurements Chemical Analysis Aquifer Test

REMARKS:

5420