

STATE ENGINEER  
Salem, Oregon

# Well Record

STATE WELL NO. 19/2W-5N

COUNTY Lane

020063

APPLICATION NO. GR-3348

OWNER: Clyde Vernon Ward

MAILING

ADDRESS: Route 2, Box 297

LOCATION OF WELL: Owner's No.


CITY AND

STATE: Creswell, Oregon

SW  $\frac{1}{4}$  SW  $\frac{1}{4}$  Sec. 5 T. 19 N. S. R. 2 E. W.M.

Bearing and distance from section or subdivision

corner 857' E. and 1444' N.

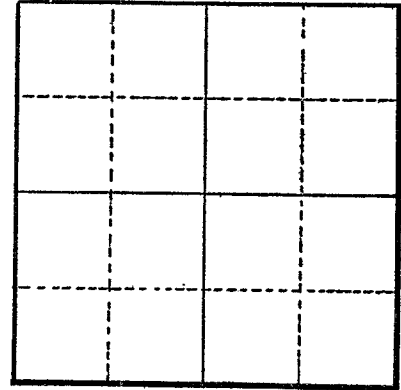

Section

Altitude at well

TYPE OF WELL: drilled Date Constructed 1952

Depth drilled 87' Depth cased 65'

CASING RECORD:

8"

FINISH:

bottom 20'

AQUIFERS:

WATER LEVEL:

50'

PUMPING EQUIPMENT: Type Fairbanks Morse H.P. 7 $\frac{1}{2}$   
Capacity 230 G.P.M.

WELL TESTS:

Drawdown ft. after hours G.P.M.

Drawdown ft. after hours G.P.M.

USE OF WATER Irrigation Temp. °F. 19

SOURCE OF INFORMATION GR-3100

DRILLER or DIGGER Casey Jones Route 2, Creswell, Oregon

ADDITIONAL DATA:

Log Water Level Measurements Chemical Analysis Aquifer Test

REMARKS: