

LANG
020026

Well Record

OWNER: J. L. & L. J. Getchell


MAILING ADDRESS: Rt. 2, Box 283

LOCATION OF WELL: Owner's No. 2

CITY AND STATE: Creswell, Oregon

NE 1/4 SE 1/4 Sec. 7 T. 19 N. S, R. 2 E. W., W.M.

Bearing and distance from section or subdivision
corner N. 13° 15' W. 1849.6 ft. from said claim
#52 (Benjamin Despain Cl.) 19S 2W

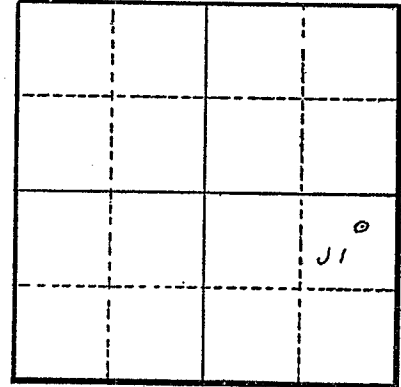

Section 7

Altitude at well 520 ft.

TYPE OF WELL: drilled Date Constructed 9/1/53

Depth drilled 97 ft. Depth cased 87 ft.

CASING RECORD: 8 inch

FINISH:

AQUIFERS:

WATER LEVEL: not known

PUMPING EQUIPMENT: Type Fairbanks Morse turbine H.P. 2
Capacity 20 G.P.M.

WELL TESTS:

Drawdown ft. after hours G.P.M.

Drawdown ft. after hours G.P.M.

USE OF WATER irrigation 50 acres Temp. °F., 19

SOURCE OF INFORMATION

DRILLER or DIGGER Casey Jones Drilling Co.

ADDITIONAL DATA:

Log Water Level Measurements Chemical Analysis Aquifer Test

REMARKS: