

STATE ENGINEER
Salem, Oregon

LANE OBSERVATION WELL
020028 Well Record

STATE WELL NO. 19/2W-7R(1)
COUNTY Lane
APPLICATION NO. GR-233

OWNER: J. L. & L. J. Getchell


MAILING ADDRESS: Rt. 2, Box 283

LOCATION OF WELL: Owner's No. 1

CITY AND STATE: Creswell, Oregon

SE 1/4 SE 1/4 Sec. 7 T. 19 S., R. 2 W., W.M.

Bearing and distance from section or subdivision corner bears N. 32° 25' W. 778.6 ft. from SE cor. Benj. Despain Cl.

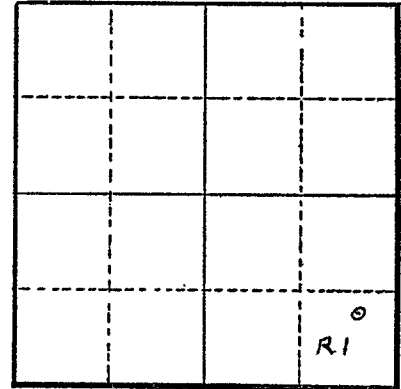

Section 7

Altitude at well 520 ft.

TYPE OF WELL: drilled Date Constructed 3/3/53

Depth drilled 148 ft. Depth cased 23 ft.

CASING RECORD: 10 inch

FINISH:

AQUIFERS:

WATER LEVEL: not known
4.34 (6-28-62)

PUMPING EQUIPMENT: Type Pacific jet H.P. 1.5
Capacity 20 G.P.M.

WELL TESTS:

Drawdown ft. after hours G.P.M.
Drawdown ft. after hours G.P.M.

USE OF WATER irrigation Temp. °F. 19

SOURCE OF INFORMATION

DRILLER or DIGGER Casey Jones Well Drilling Co.

ADDITIONAL DATA:

Log Water Level Measurements Chemical Analysis Aquifer Test

REMARKS:

