

STATE ENGINEER  
Salem, Oregon

LANE  
020043

# Well Record

STATE WELL NO. 19/2W-8M  
COUNTY Lane  
APPLICATION NO. GR-3945

OWNER: Sam Prilliman


MAILING ADDRESS: Route 2, Box 280

LOCATION OF WELL: Owner's No.

CITY AND STATE: Creswell, Oregon

N. E.  
NW 1/4 SW 1/4 Sec. 8 T. 19 S., R. 2 W., W.M.

Bearing and distance from section or subdivision  
corner 1150 feet South and 550 feet East from  
the W 1/4 Corner, Section 8

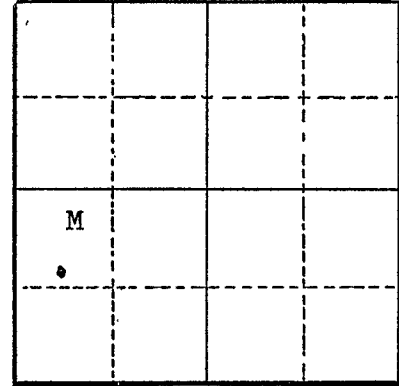

Altitude at well 500 feet

Section 8

TYPE OF WELL: Drilled Date Constructed 10-17-52

Depth drilled 116 feet Depth cased

### CASING RECORD:

### FINISH:

### AQUIFERS:

### WATER LEVEL:

23 feet

PUMPING EQUIPMENT: Type Layne-Bower H.P.  
Capacity G.P.M.

### WELL TESTS:

Drawdown 70 ft. after hours 250 G.P.M.  
Drawdown ft. after hours G.P.M.

USE OF WATER Irrigation Temp. °F., 19

SOURCE OF INFORMATION GR-4041

DRILLER or DIGGER Casey Jones Pleasant Hill, Oregon

### ADDITIONAL DATA:

Log (NA) Water Level Measurements Chemical Analysis Aquifer Test

### REMARKS: