

STATE ENGINEER
Salem, Oregon

LANE
020495


Well Record

STATE WELL NO. 19/3-13^wF
COUNTY Lane
APPLICATION NO. GR-3345

OWNER: Earle and Clara Benton MAILING ADDRESS: Rt. 2, Box 200

LOCATION OF WELL: Owner's No. _____ CITY AND STATE: Creswell, Oregon

SE 1/4 SW 1/4 Sec. 13 T. 19 S., R. 3 W., W.M.
Bearing and distance from section or subdivision
corner 1750' E. & 670' N. from SW corner of NW 1/4
or W 1/4 corner 13

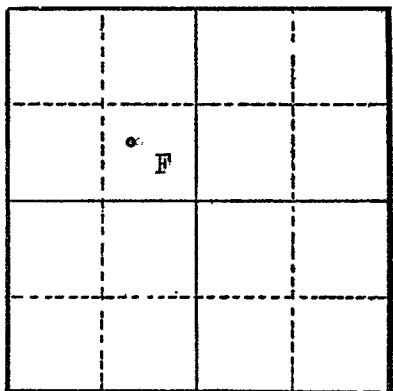

Section 13

Altitude at well _____

TYPE OF WELL: Drilled Date Constructed 1936

Depth drilled 20' Depth cased 20'

CASING RECORD:

2"

FINISH:

Slotted 17 to 20

AQUIFERS:

WATER LEVEL:

15'

PUMPING EQUIPMENT: Type Fairbanks Morse H.P. Gas

Capacity 50 G.P.M.

WELL TESTS:

Drawdown _____ ft. after _____ hours _____ G.P.M.

Drawdown _____ ft. after _____ hours _____ G.P.M.

USE OF WATER Irrigation Temp. _____ °F. _____, 19 _____

SOURCE OF INFORMATION GR-3989

DRILLER or DIGGER _____

ADDITIONAL DATA:

Log _____ Water Level Measurements _____ Chemical Analysis _____ Aquifer Test _____

REMARKS: