

STATE ENGINEER
Salem, Oregon

LANE
020537

Well Record

STATE WELL NO. 19/3W-14F
COUNTY Lane
APPLICATION NO. GR-2236

OWNER: City of Creswell

MAILING
ADDRESS:

LOCATION OF WELL: Owner's No.


CITY AND
STATE: Creswell, Oregon

SE 1/4 NW 1/4 Sec. 14 T. 19 S. R. 3 W., W.M.

Bearing and distance from section or subdivision

corner 2050 feet East and 1550 feet South from

NW Corner, Section 14, being within Hughes Addition

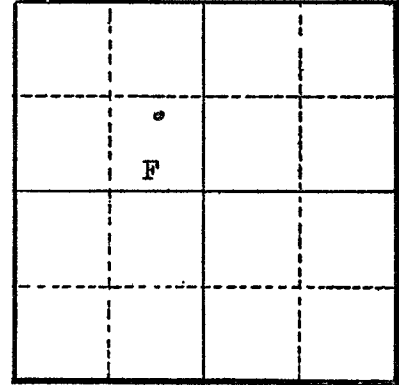

Section 14

Altitude at well

TYPE OF WELL: Drilled Date Constructed May 1945

Depth drilled 138 feet Depth cased 140

CASING RECORD:

8-inch casing set from 0 to 140 feet

FINISH:

perforated from 121 to 138 feet

AQUIFERS:

WATER LEVEL:

39 feet

PUMPING EQUIPMENT: Type Pacific Highlift H.P.
Capacity 25 G.P.M.

WELL TESTS:

Drawdown 97 ft. after hours 40 G.P.M.

Drawdown ft. after hours G.P.M.

USE OF WATER Municipal Temp. °F., 19

SOURCE OF INFORMATION GR-4024

DRILLER or DIGGER

ADDITIONAL DATA:

Log (NA) Water Level Measurements Chemical Analysis Aquifer Test

REMARKS: