

STATE ENGINEER
Salem, Oregon

LANE Well Record
020538

STATE WELL NO. 19/3W-14G
COUNTY Lane
APPLICATION NO. GR-2237

OWNER: City of Creswell

MAILING

ADDRESS:

LOCATION OF WELL: Owner's No.

3

CITY AND

STATE:

Creswell, Oregon

SW $\frac{1}{4}$ NE $\frac{1}{4}$ Sec. 14 T. 19 S., R. 3 W., W.M.

Bearing and distance from section or subdivision

corner 1130 feet South and 1640 feet West from


$\frac{1}{4}$ Corner, Section 14, being within Calab

Colvin Donation #

Altitude at well

TYPE OF WELL: Drilled Date Constructed May, 1953

Depth drilled 210 feet Depth cased 210 feet

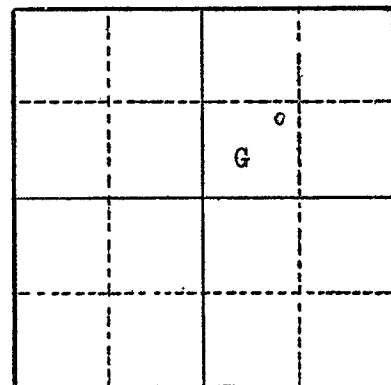

Section 14

CASING RECORD:

10-inch casing set from 0 to 73 feet

8-inch casing set from 73 to 210 feet

FINISH:

Perforated from 73 to 210 feet

AQUIFERS:

WATER LEVEL:

20 feet

PUMPING EQUIPMENT: Type Cook Turbine H.P.
Capacity 90 G.P.M.

WELL TESTS:

Drawdown 45 ft. after hours 90 G.P.M.

Drawdown ft. after hours G.P.M.

USE OF WATER Municipal Temp. °F., 19

SOURCE OF INFORMATION GR-4025

DRILLER or DIGGER Casey Jones, Springfield, Oregon

ADDITIONAL DATA:

Log (NA) Water Level Measurements Chemical Analysis Aquifer Test

REMARKS: