

STATE ENGINEER
Salem, Oregon

LANE
020599 Well Record


STATE WELL NO. 19/3W-14J
COUNTY Lane
APPLICATION NO. GR-2375

OWNER: William C. Adams
MAILING ADDRESS: 655 Mary Neal Lane. PO Box 426

CITY AND STATE: Creswell, Oregon

LOCATION OF WELL: Owner's No. _____
NE 1/4 SE 1/4 Sec. 14 T. 19 N. S. R. 3 W., W.M.

Bearing and distance from section or subdivision
corner 1489.88 feet North and 921.66 feet East
from the SW Corner, DLC 53.

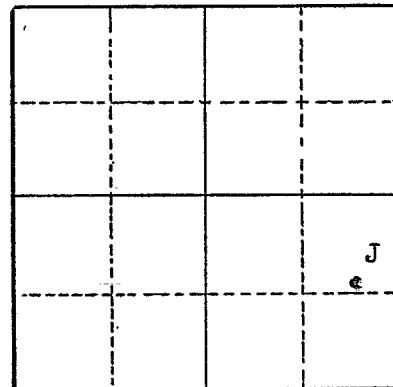

Altitude at well about 500 feet

TYPE OF WELL: Drilled Date Constructed Oct - 1953

Depth drilled 100 feet Depth cased _____

Section 14

CASING RECORD:

6-inch about 60 feet

FINISH:

AQUIFERS:

sand and clay

WATER LEVEL:

about 25 feet

PUMPING EQUIPMENT: Type Fairbanks Morse H.P. 1
Capacity 1000 gph (20 g.p.m.)

WELL TESTS:

Drawdown _____ ft. after _____ hours 425 G.P.M.
Drawdown _____ ft. after _____ hours _____ G.P.M.

USE OF WATER Irrigation Temp. _____ °F. _____, 19

SOURCE OF INFORMATION GR-4039

DRILLER or DIGGER _____

ADDITIONAL DATA:

Log ☒ Water Level Measurements _____ Chemical Analysis _____ Aquifer Test _____

REMARKS:

Sand and Clay Intermittently