

STATE ENGINEER
Salem, Oregon

Well Record
LANE 020540

STATE WELL NO. 19/3W-14M
COUNTY Lane
APPLICATION NO. GR-2235

OWNER: City of Creswell

MAILING

ADDRESS:

LOCATION OF WELL: Owner's No. 1

CITY AND


STATE: Creswell, Oregon

NW 1/4 SW 1/4 Sec. 14 T. 19 N. S., R. 3 E. W., W.M.

Bearing and distance from section or subdivision

corner 550 feet East and 25 feet South from the W 1/4 Corner,

Section 14

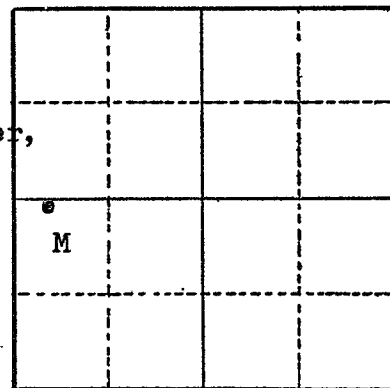

Section 14

Altitude at well

TYPE OF WELL: Drilled Date Constructed April, 1939

Depth drilled 165 feet Depth cased 163 feet

CASING RECORD:

8-inch casing set from 0 to 163 feet

FINISH:

perforated from 141 feet to 153 feet

AQUIFERS:

WATER LEVEL:

35 feet

PUMPING EQUIPMENT: Type Cook Turbine

H.P.

Capacity 120 G.P.M.

WELL TESTS:

Drawdown 150 ft. after hours 60 G.P.M.

Drawdown ft. after hours G.P.M.

USE OF WATER Municipal Temp. °F., 19

SOURCE OF INFORMATION GR-4023

DRILLER or DIGGER Strawser, Portland, Oregon

ADDITIONAL DATA:

Log (NA) Water Level Measurements Chemical Analysis Aquifer Test

REMARKS: