

STATE ENGINEER  
Salem, Oregon

**LANE**  
**020682**

# Well Record

STATE WELL NO. 19/3W-20B  
COUNTY Lane  
~~APPLICATION NO.~~ GR-3407

OWNER: John C. Clevenger

MAILING  
ADDRESS:

Route 1, Box 830

LOCATION OF WELL: Owner's No.

CITY AND  
STATE:

Creswell, Oregon

NW  $\frac{1}{4}$  NE  $\frac{1}{4}$  Sec. 20 T. 19 <sup>N.</sup> S. <sup>E.</sup> R. 3 W., W.M.

Bearing and distance from section or subdivision


corner 150' W. and 95' S.

Altitude at well

TYPE OF WELL: drilled Date Constructed 1951

Depth drilled 60' Depth cased 55'

CASING RECORD:  
6"

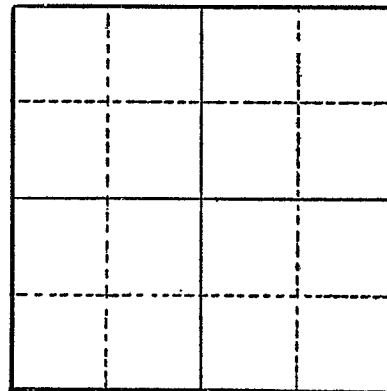

Section

FINISH:

holes from 50 to 55

AQUIFERS:

WATER LEVEL:

30'

PUMPING EQUIPMENT: Type Fairbanks Morse  
Capacity 13 G.P.M.

H.P. 1

WELL TESTS:

Drawdown ft. after hours pumping 13 G.P.M.

Drawdown ft. after hours G.P.M.

USE OF WATER Irrigation Temp. °F. 19

SOURCE OF INFORMATION GR-3149

DRILLER or DIGGER Emerson

ADDITIONAL DATA:

Log Water Level Measurements Chemical Analysis Aquifer Test

REMARKS: