

STATE ENGINEER
Salem, Oregon

LANE

Well Record

020776

STATE WELL NO. 19/3W-23 H
COUNTY LANE
APPLICATION NO. GR-2833

OWNER: Hubert H. Dersham Jr

MAILING
ADDRESS:

Rt. 1


LOCATION OF WELL: Owner's No.

CITY AND
STATE:

Creswell, Oregon

SE 1/4 NE 1/4 Sec. 23 T. 19 S., R. 3 W., W.M.

Bearing and distance from section or subdivision
corner about 45' W of E line of property, and 210'
S of center of county road no. 637 & E 520'
from center of Hillview.

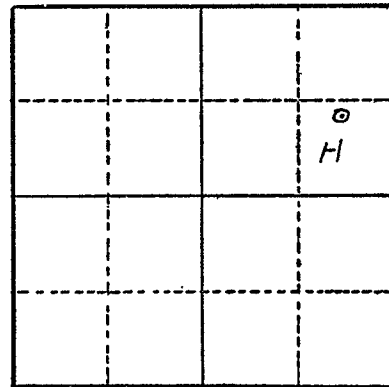

Altitude at well

TYPE OF WELL: Dug Date Constructed 1952

Depth drilled 16' Depth cased 14

Section 23

CASING RECORD:

16-inch

FINISH:

AQUIFERS:

WATER LEVEL:

10'

PUMPING EQUIPMENT: Type Cent. Fairbanks Morse
Capacity 70 G.P.M.

H.P. 1

WELL TESTS:

Drawdown ft. after hours G.P.M.

Drawdown ft. after hours G.P.M.

USE OF WATER Irrigation Temp. °F., 19

SOURCE OF INFORMATION GR-3885

DRILLER or DIGGER

ADDITIONAL DATA:

Log NA Water Level Measurements Chemical Analysis Aquifer Test

REMARKS: