

STATE ENGINEER  
Salem, Oregon

**LANE**  
**020870 Well Record**

STATE WELL NO. 19/3W-26H  
COUNTY Lane  
APPLICATION NO. GR-1764

OWNER: John G. or Frances E. Lamb

MAILING ADDRESS: Creswell

LOCATION OF WELL: Owner's No.

CITY AND STATE: Oregon


Lot 3SE 1/4 NE 1/4 Sec. 26 T. 19 N. S, R. 3 E. W., W.M.

Bearing and distance from section or subdivision corner

Altitude at well

TYPE OF WELL: Drilled Date Constructed 1953

Depth drilled 95 Depth cased 95

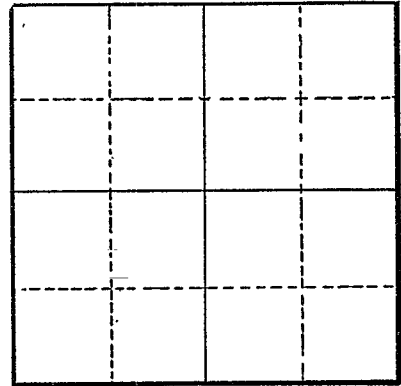

Section 26

CASING RECORD:

5-inch from 0 to 95 feet

FINISH:

No perforations

AQUIFERS:

Sand and gravel

WATER LEVEL:

7 feet

PUMPING EQUIPMENT: Type Fairbanks Morse Jet H.P. 2  
Capacity 60 G.P.M.

WELL TESTS:

Drawdown ft. after hours G.P.M.  
Drawdown ft. after hours G.P.M.

USE OF WATER Irrigation Temp. °F., 19

SOURCE OF INFORMATION GR-1764

DRILLER or DIGGER

ADDITIONAL DATA:  
Log Water Level Measurements Chemical Analysis Aquifer Test

REMARKS: