

NOTICE TO WATER WELL CONTRACTOR

The original and first copy of this report are to be filed with the

STATE ENGINEER, SALEM, OREGON 97310 within 30 days from the date of well completion.

RECEIVED WATER WELL REPORT 022028 SEP 29 1965 STATE ENGINEER

STATE OF OREGON (Please type or print)

State Well No. 20/3w-11C/2 State Permit No.

(1) OWNER: Oregon SALEM OREGON Name State Highway Dept. Address State Highway Building Salem, Oregon

(2) LOCATION OF WELL: County Lane Driller's well number Well # 3 1/4 Section 11/4 T. 20S R. 3W W.M. Bearing and distance from section or subdivision corner

Highway Station 549+15 Mile post 140 900 ft. South of Gettings Creek on Pacific Highway.

(3) TYPE OF WORK (check): New Well [X] Deepening [] Reconditioning [] Abandon [] Abandonment, describe material and procedure in Item 12.

(4) PROPOSED USE (check): Domestic [] Industrial [] Municipal [] Irrigation [X] Test Well [] Other [] (5) TYPE OF WELL: Rotary [] Driven [] Cable [X] Jetted [] Dug [] Bored []

(6) CASING INSTALLED: Threaded [] Welded [X] 6" Diam. from 0 ft. to 20 ft. Gage 250 5" Diam. from 15 ft. to 75 ft. Gage 250

(7) PERFORATIONS: Perforated? [X] Yes [] No Type of perforator used torch Size of perforations 1/4 in. by 6 in. 220 perforations from 20 ft. to 75 ft.

(8) SCREENS: Well screen installed? [X] Yes [] No Manufacturer's Name Model No. Slot size Set from ft. to ft. Diam. Slot size Set from ft. to ft.

(9) CONSTRUCTION: Well seal—Material used in seal cement Depth of seal 18 ft. Was a packer used? no Diameter of well bore to bottom of seal in. Were any loose strata cemented off? [X] No Depth Was a drive shoe used? [X] Yes [] No Was well gravel packed? [] Yes [X] No Size of gravel: Gravel placed from ft. to ft. Did any strata contain unusable water? [] Yes [X] No Type of water? depth of strata Method of sealing strata off

(10) WATER LEVELS: Static level 5 ft. below land surface Date 9/8/65 Artesian pressure lbs. per square inch Date

(11) WELL TESTS: Drawdown is amount water level is lowered below static level Was a pump test made? [X] Yes [] No If yes, by whom? Yield: 45 gal./min. with 23 ft. drawdown after 6 hrs.

Bailer test gal./min. with ft. drawdown after hrs. Artesian flow g.p.m. Date Temperature of water Was a chemical analysis made? [] Yes [X] No

(12) WELL LOG: Diameter of well below casing 6 Depth drilled 75 ft. Depth of completed well 75 ft. Formation: Describe by color, character, size of material and structure, and show thickness of aquifers and the kind and nature of the material in each stratum penetrated, with at least one entry for each change of formation.

Table with 3 columns: MATERIAL, FROM, TO. Rows include Dirt and gravel (0-10), Red shale rock (10-39), Black rock (39-52), Basalt (52-57), Grey rock (57-75).

Work started 9/3/65 19 Completed 9/8/65 19 Date well drilling machine moved off of well 9/8/65 19


(13) PUMP: Manufacturer's Name Type: H.P.

Water Well Contractor's Certification: This well was drilled under my jurisdiction and this report is true to the best of my knowledge and belief.

NAME W. W. Drilling and Pump Service (Person, firm or corporation) (Type or print) Address 4157 Main St. Springfield, Ore. Drilling Machine Operator's License No. 336 [Signed] Walt Wilson (Water Well Contractor) Contractor's License No. 268 Date 9/14/65, 19

OREGON STATE HIGHWAY DEPARTMENT

Calculations for X-SECTION OF 75 FT WELL
Made by DDA 9/8 1965 Checked by _____, 19____ Backchecked by _____, 19____

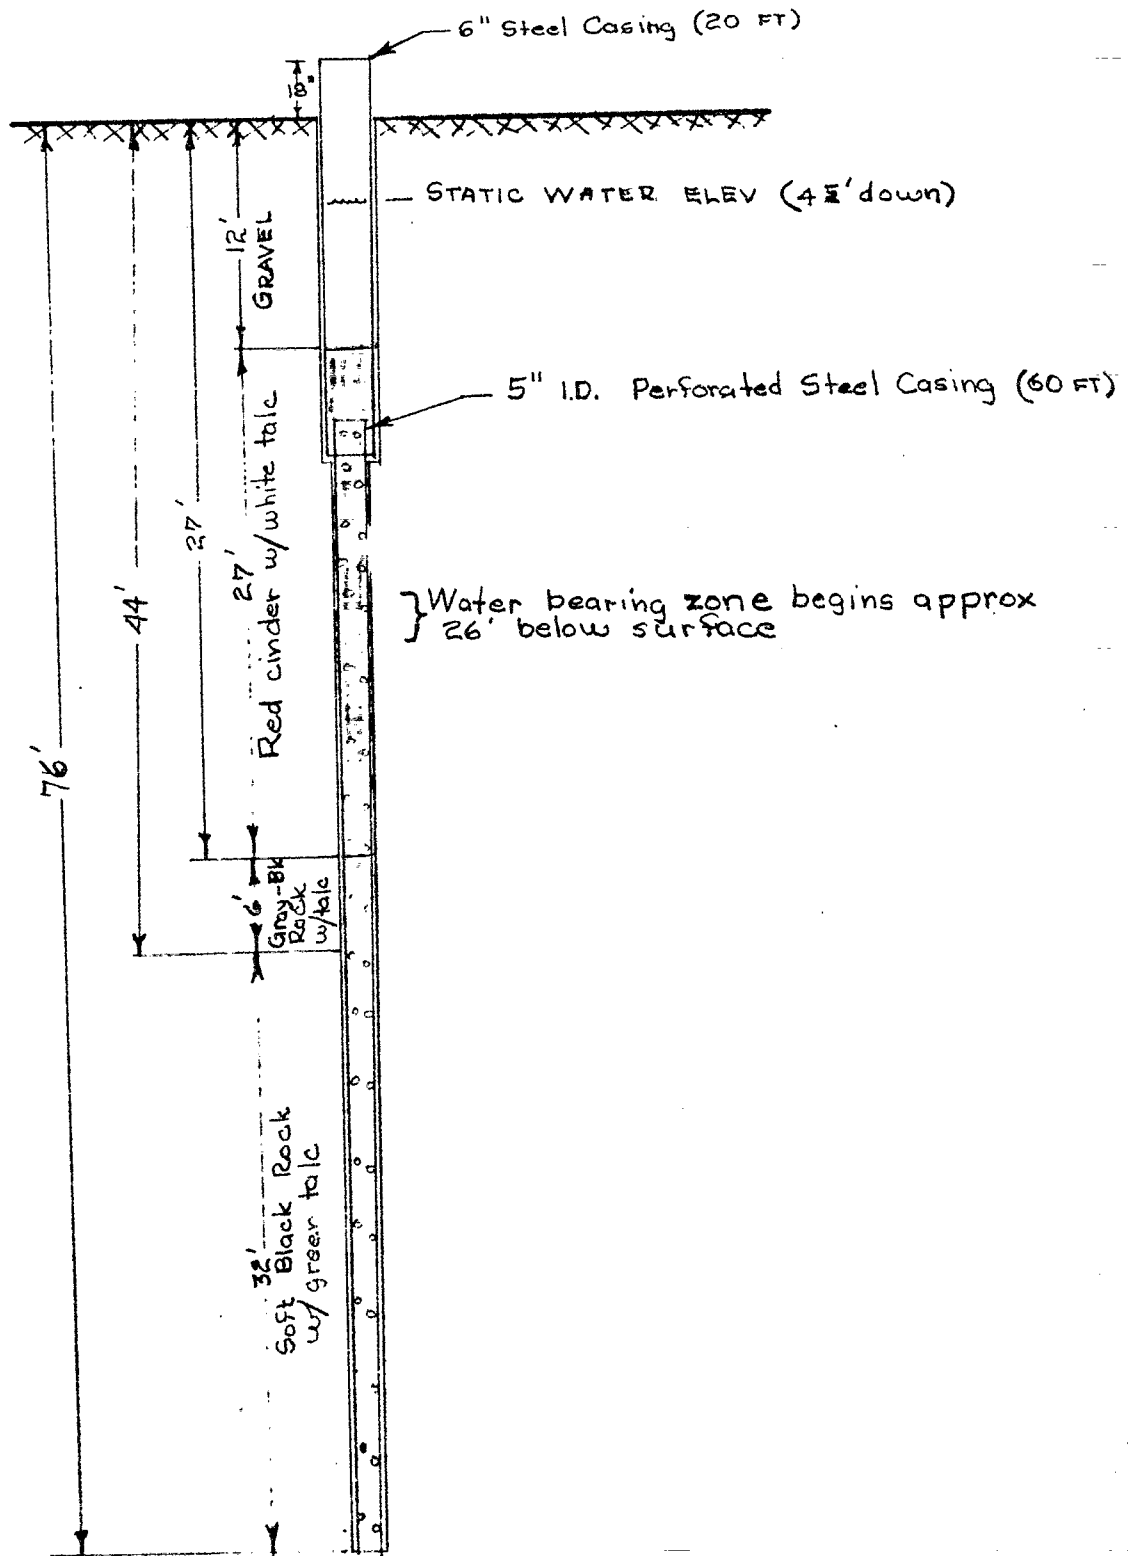

Vert Scale 1" = 10'

L. R. Chandler

- 2 -

September 8, 1965

minimum of 20 GPM required. Walt Wilson of W. W. Drilling estimated capacity between 55 and 60 GPM. Well recovered to 7.5 feet below surface in 20 minutes.

Samples of water were taken on 9-7-65 for a bacteriological examination. The water is clear with no undesirable taste.

D. J. Sage
Dist. Maint. Supt.

By *Dale D. Allen*

Dale D. Allen
Asst. Dist. Maint. Supt.

DDA:em

cc: Mark Astrup
Jack Scova
W. P. Milne

OREGON STATE HIGHWAY DEPARTMENT
INTER-DEPARTMENT CORRESPONDENCE

20/3w-11
RECEIVED
SEP 30 1965
STATE ENGINEER
SALEM OREGON

Eugene, Oregon

September 8, 1965

To: L. R. Chandler
Division Engineer

SUBJECT: Well Drilling Report
Gettings Creek Rest Area

Attention: Carl Williams

This report covers the drilling and pump testing done on the third well drilled at the Gettings Creek Rest Area.

Well Location - MP 140.4 - Interstate I-5
West of Sta. 549+15 and 10' E. of W.
R/W Fence.
Depth - - - - 75 feet
Casing - - - - 18 feet of 6" casing
60 feet of 5" perforated casing
Driller - - - - W. W. Drilling, 4157 Main St., Springfield.

August 30, 1965 - W. W. Drilling moved in and set up.
August 31, 1965 - Began drilling. Drilled 20 feet.
September 1, 1965 - Drilled to 52 feet and stopped.
September 3, 1965 - Ran bailer test at 52 feet.

Results of Bailer Test


In 30 min. 1800 gals. was bailed.
Approx. drawdown at end of test was 18 feet.
Estimated capacity of well - Over 45 Gal/Min.
September 3, 1965 (Con't) - Drilled to 75 feet depth and sealed well.
September 7, 1965 - Ran pump test with suction pump.

Results of Pump Test

After first 15 min. of pumping, the pump discharged it's max. capacity of 44 GPM for 5 hrs., 45 min. with a stable drawdown of 21.9 feet below static level. This test, therefore, does not indicate the max. capacity the well can produce but indicates it is over 44 GPM and over the

20/3w-11

Gettings Creek
Rest Area
44 G/M
B hr
Pump
Test

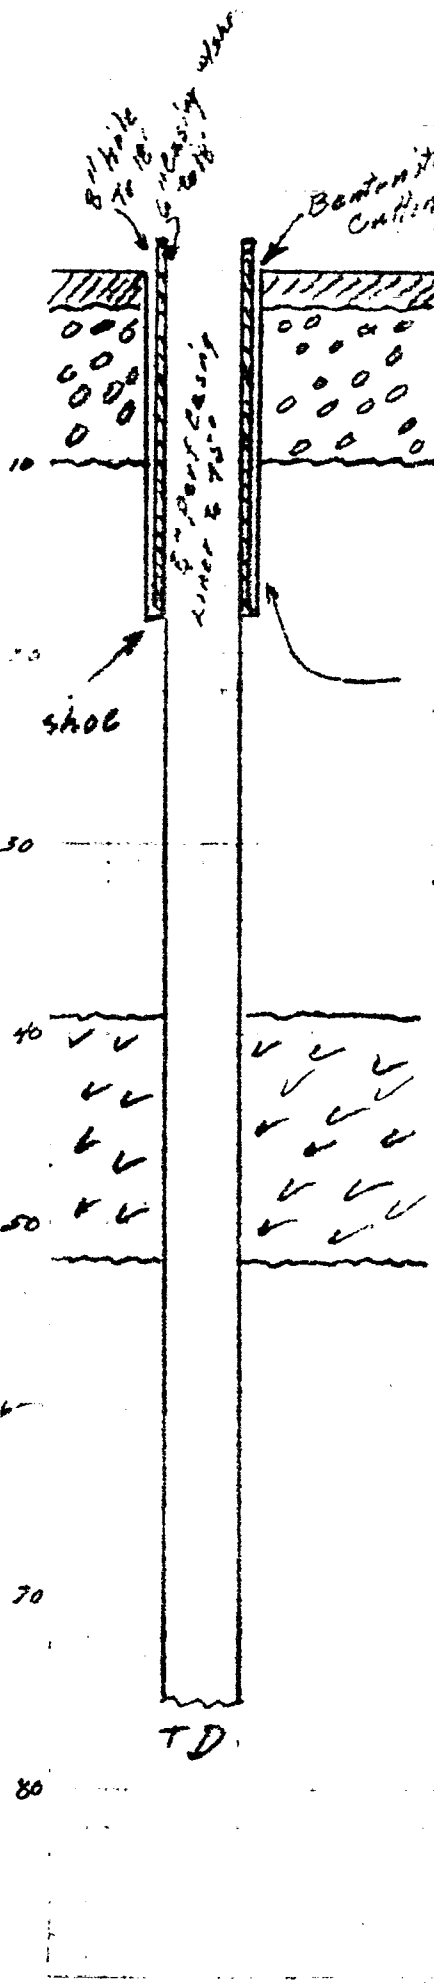

Top Soil
Sandy Gravel
seismic TOP
Red Volcanic Ash

Seal 5 sack slurry

seismic TOP

Gray Basalt or Andisite

Static Level

30 G/M
45 G/M
40 G/M

during TEST
Very little
water here

44 G/M

Caving Zone
Some H₂O
Driller Reported
Large Amount
of Water
from this
Zone

Bottom of
Hole for
Bail
Test.

TD

OREGON STATE HIGHWAY DEPARTMENT

INTER-DEPARTMENT CORRESPONDENCE

Salem, Oregon

September 9, 1965

RECEIVED
 SEP 10 1965
 STATE ENGINEER
 SALEM, OREGON

To:

F. W. Yarbrough
 Staff Assistant
 S H O P S

SUBJECT:

Water Well #3
 Gettings Creek Rest Area
 Goshen - Cottage Grove Section
 Pacific Highway I-5
 Lane County
 11' East of P.O.T. Ref. Pin.
 Sta. 549+15 located in West
 R. W. Fence

This well was located in an essentially water poor area by the combination of extensive surface geologic reconnaissance and detailed sub-surface geophysical investigations. (See report July, 1965). The well seems capable of a sustained yield of better than 44 gal./min. This is based on the Bailor and Pump tests conducted to date.

It is believed that the bulk of the water is entering the well between the second seismic top and the top of the gray basalt or andesite layer.

It was recommended that the method of completion be modified from specifications to that illustrated on the accompanying sheet of drawings because of the nature of the red volcanic ash. If the 6" casing were driven into the basalt layer, there would be a great risk of sealing off the water with clay and not being able to recover it upon perforation of the casing. Other reasons for this type of completion in this situation are:

- 1) The liner can be removed and the perforations cleaned.
- 2) With the liner cut, the well can be cleaned, despensed, or reamed.
- 3) This all can be done without disturbing the seal which prevents the surface water from entering the well.
- 4) This method was discussed with Jack Sceva and William Bartholomew of the State Engineer's office. They express their approval.

During the discussion with Mr. Sceva and Mr. Bartholomew the following additional points were covered:

- 1) If this water is part of the general perched water table, it would be necessary to have a treatment unit on the line at this time to take care of possible contamination during the recharge season.

September 9, 1965

2) If this water is separate from the general perched water table, then there is a good possibility that the water will rise over the top of the casing and become an artesian flow during the recharge season.

3) The top of the casing should be above the highest recorded flood level.

4) To obtain an indication of the probable recharge source it would be helpful to know:

- a) static level elevations of the three wells
- b) the temperature of the water in the three wells
- c) the comparative mineral content of the water from the wells
(the above information could be obtained by the local personnel)

5) Finding another well in the immediate vicinity of the rest area with a potential of more than 10 gal./min would be extremely difficult to impossible.

6) The water is cold, tastes good, and feels soft. The chemical and bacteriological tests will indicate the suitability for human consumption.

Summary: This is an extremely good well.

William P. Milne
Assistant Geologist

WFM:ks

cc: F. D. Morgan
Mark Astrup
Jack Seeva ✓
R. L. Chandler
D. J. Sage
R. J. Van Cleave

Rest Area
Diagram of
Well #3


Bail Test Pump Test

6 hr @ 44 GPM

CLEVELAND PAPER CO. NO. 3130 10 DIVISIONS PER INCH BOTH VAYS 20 X 100 DIVISIONS

CLEVELAND PAPER CO.

PRINTED IN U.S.A. ON CLEVELAND TECHNICAL PAPER NO. 1012

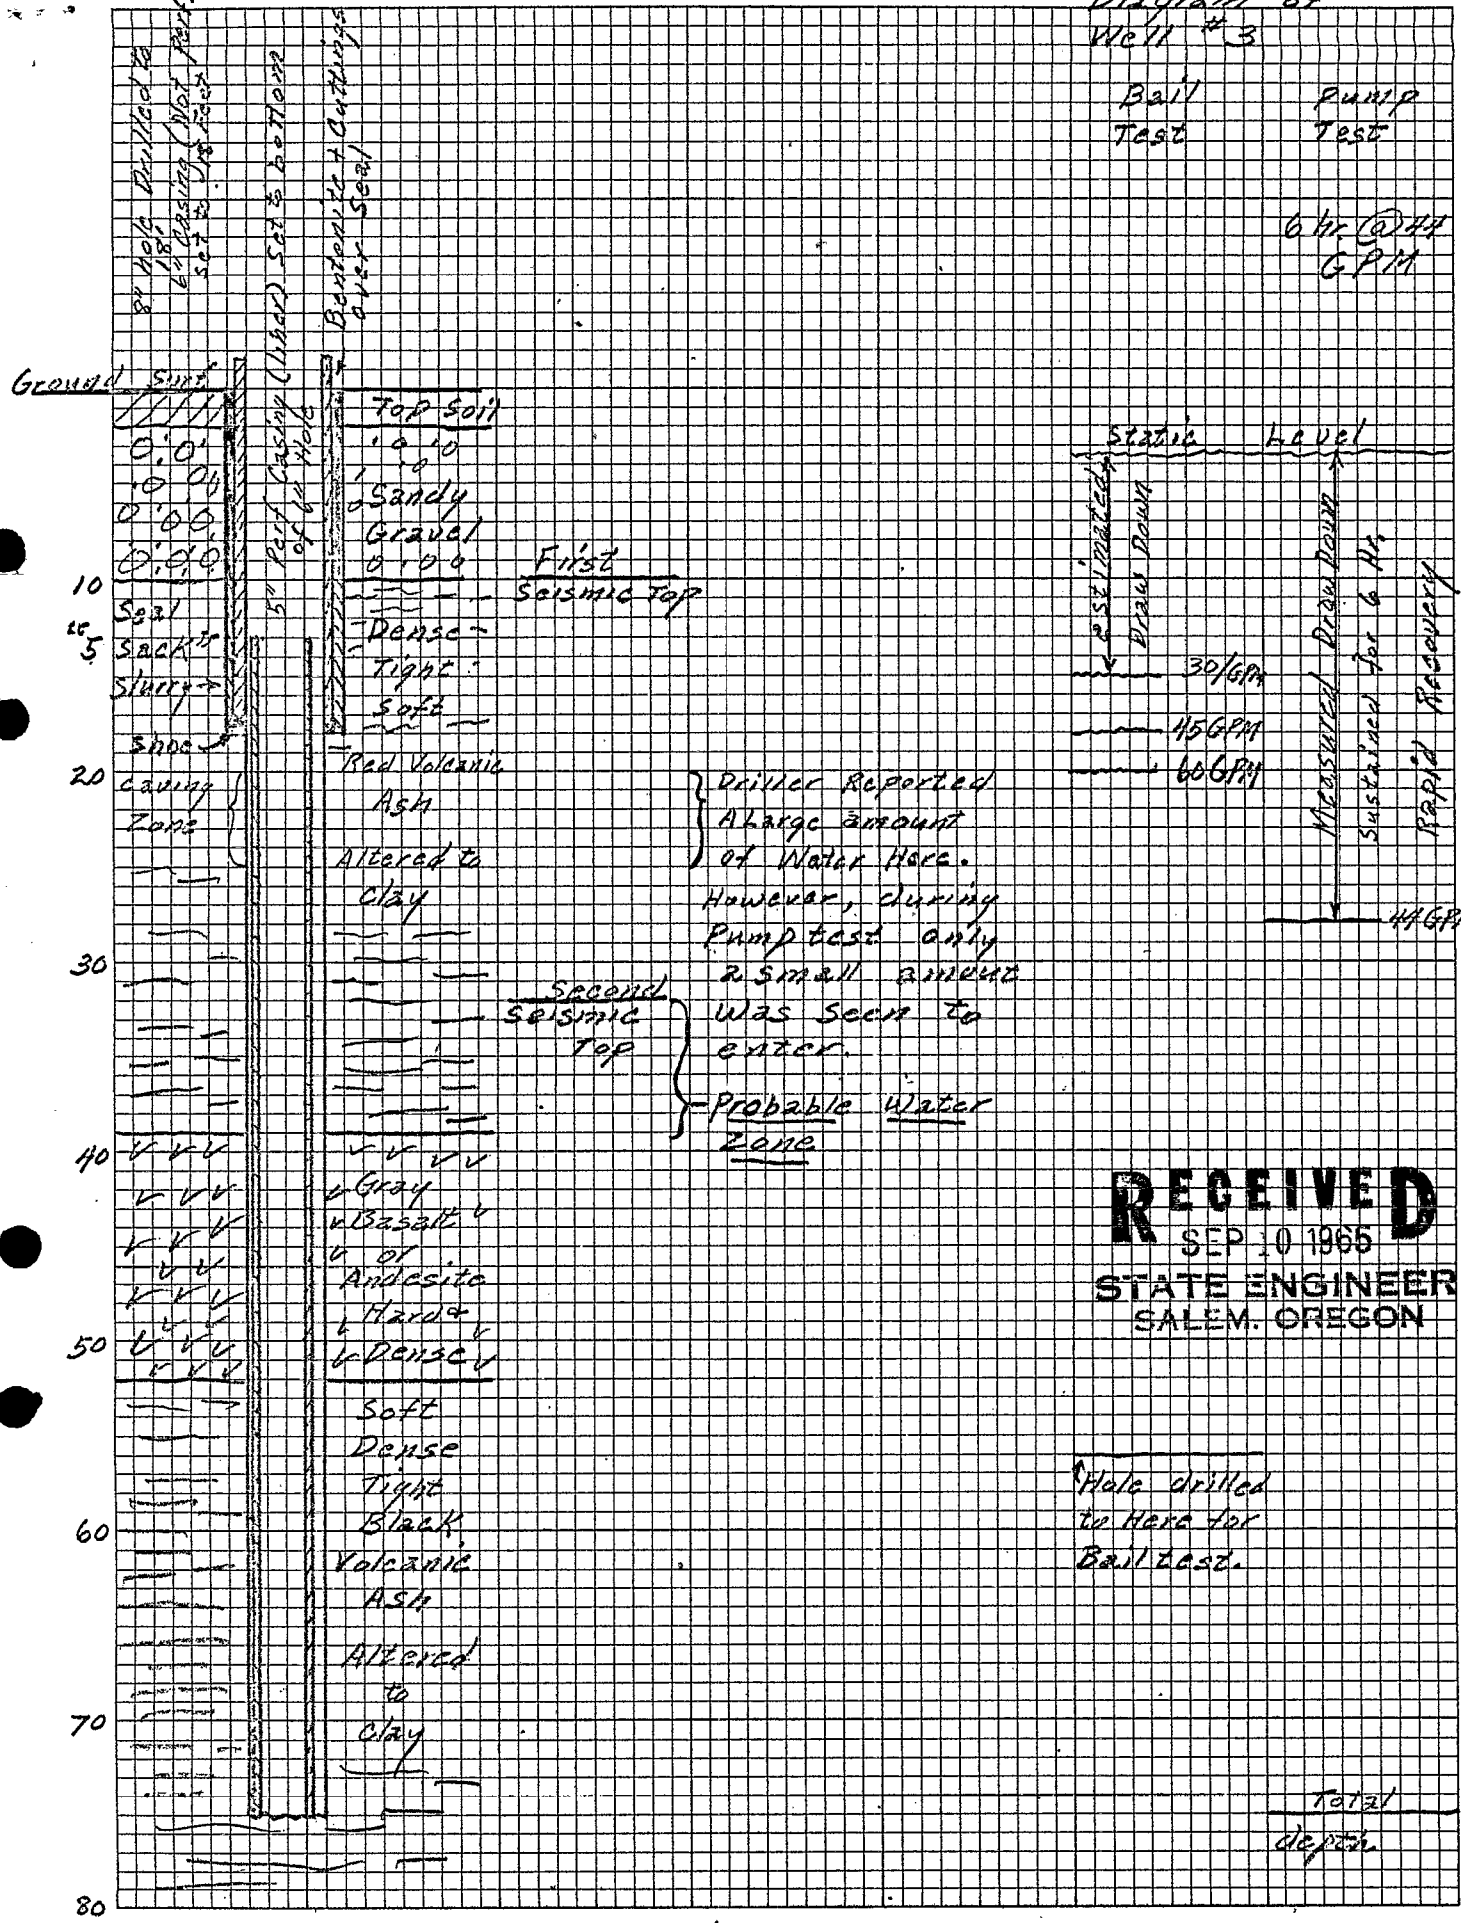

RECEIVED
SEP 10 1965
STATE ENGINEER
SALEM, OREGON

Total depth

REQUEST FOR WATER BACTERIOLOGICAL EXAMINATION

NAME OF WATER SUPPLY OR SWIMMING POOL: 75' WELL GETTING'S CR REST AREA

ADDRESS OR LOCATION: MP 140 I-5 Highway

DATE COLLECTED: 9 / 7 / 65 HOURS: A.M. P.M.

NAME OF COLLECTOR: Dale Allen - Assn OMS

SAMPLING POINT: Pump Disch. SOURCE: Well COUNTY: Lane

CHLORINATED MUNICIPAL OR UNCHLORINATED COMMUNITY SEMI-PUBLIC PRIVATE

SWIMMING POOL AND BATHING PLACES: ARTIFICIAL POOL NATURAL BATHING PLACE

SEND REPORT TO: ORE STATE HWY
Box 1269, Eugene
% D. J. Sage ORE

REMARKS: 1st sample of 75' well on Interstate Hwy I-5

HL-10 REV. 10-59 SEE REVERSE SIDE

LAB. NO. 22276

THIS WATER DOES DOES NOT

CONFORM WITH ACCEPTED STANDARDS OF PURITY.

DATE RECEIVED: 9-8-65 DATE REPORTED: 9-11-65

SEE BACK OF 1ST COPY FOR ADDL. INFO.

VOL.-ML	1	10	10	10	10	10	MPN
24 HOURS	-	-	-	-	-	-	-
48 HOURS	-	-	-	+	-	+	-
CON-FIRMATION				+		+	

VOL.-ML	10.	10.	1.	1.	.1	.1	.01	.01	MPN
24 HOURS									
48 HOURS									
CON-FIRMATION									

CHECKED BY: JP

PUBLIC HEALTH LABORATORY
 OREGON STATE BOARD OF HEALTH
 P. O. BOX 231, PORTLAND, OREGON 97207

REQUEST FOR WATER BACTERIOLOGICAL EXAMINATION

NAME OF WATER SUPPLY OR SWIMMING POOL: 75' WELL GETTING'S CR REST AREA

ADDRESS OR LOCATION: MP 140 - I-5 Hwy

DATE COLLECTED: 9 / 7 / 65 HOURS: A.M. P.M.

NAME OF COLLECTOR: Dale D. Allen Assn OMS

SAMPLING POINT: Pump Disch. SOURCE: Well COUNTY: Lane

CHLORINATED MUNICIPAL OR UNCHLORINATED COMMUNITY SEMI-PUBLIC PRIVATE

SWIMMING POOL AND BATHING PLACES: ARTIFICIAL POOL NATURAL BATHING PLACE

SEND REPORT TO: ORE STATE HWY
Box 1269; Eugene
% D. J. Sage ORE

REMARKS: 2nd sample of 75' well on Getting's Cr Rest Area

HL-10 REV. 10-59 SEE REVERSE SIDE

LAB. NO. 22275

THIS WATER DOES DOES NOT

CONFORM WITH ACCEPTED STANDARDS OF PURITY.

DATE RECEIVED: 9-8-65 DATE REPORTED: 9-11-65

SEE BACK OF 1ST COPY FOR ADDL. INFO.

VOL.-ML	1	10	10	10	10	10	MPN
24 HOURS	-	-	-	-	-	-	-
48 HOURS	-	+	+	-	-	+	-
CON-FIRMATION		+	+			+	

VOL.-ML	10.	10.	1.	1.	.1	.1	.01	.01	MPN
24 HOURS									
48 HOURS									
CON-FIRMATION									

CHECKED BY: JP

PUBLIC HEALTH LABORATORY
 OREGON STATE BOARD OF HEALTH
 P. O. BOX 231, PORTLAND, OREGON 97207