

STATE ENGINEER  
Salem, Oregon

Well Record ~~LANE~~ STATE WELL NO. 20/3W-27K  
022284 COUNTY Lane  
APPLICATION NO. GR-3551

OWNER: John Nowak


MAILING ADDRESS: Route 1, Box 10

LOCATION OF WELL: Owner's No.

CITY AND STATE: Cottage Grove, Oregon

W 1/4 SE 1/4 Sec. 27 T. 20 S. R. 3 E W., W.M.

Bearing and distance from section or subdivision corner 1970 ft. N. and 1095 ft. W. from SE corner of John Partin D.L.C. #64

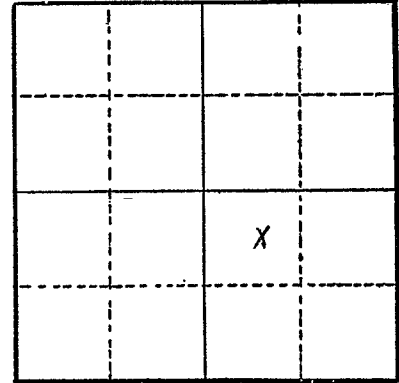

Section 27

Altitude at well

TYPE OF WELL: Dug & Drill Date Constructed July, 1951

Depth drilled 50 ft. Depth cased

CASING RECORD:

Dug 10 ft. Drilled 40 ft.  
60 inch casing set to 10 ft. 12 inch casing set from 10 to 30 ft.

FINISH:

Perforated from 10 ft. from top to 30 ft. level

AQUIFERS:

Gravel

WATER LEVEL:

6 feet below surface

PUMPING EQUIPMENT: Type Mont. Ward electric 3 phase H.P. 5  
Capacity 200 G.P.M.

WELL TESTS:

Drawdown 50 ft. after hours 125 G.P.M.  
Drawdown ft. after hours G.P.M.

USE OF WATER Irrigation Temp. °F. 19

SOURCE OF INFORMATION Well Registration Statement

DRILLER or DIGGER

ADDITIONAL DATA:

Log  Water Level Measurements  Chemical Analysis  Aquifer Test

REMARKS:

Log:  
Gravel except for top 2 feet of soil