

STATE ENGINEER
Salem, Oregon

LANE
022460

Well Record


STATE WELL NO. 20/3W-33B
COUNTY LANE
APPLICATION NO. GR-2976

OWNER: Joseph A. Barta MAILING ADDRESS: 1445 S. 8th

LOCATION OF WELL: Owner's No. _____ CITY AND STATE: Cottage Grove, Oregon

NW 1/4 NE 1/4 Sec. 33 T. 20 S., R. 3 W., W.M.

Bearing and distance from section or subdivision corner 937.0' E. and 75.0' N. of the SW corner
DLC #56.

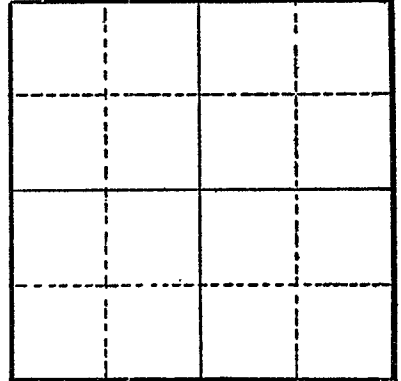

Section

Altitude at well _____

TYPE OF WELL: dug Date Constructed 1950

Depth drilled 12 Depth cased _____

CASING RECORD:

FINISH:

AQUIFERS:

Clay and sandstone

WATER LEVEL:

2-feet

PUMPING EQUIPMENT: Type McDonald Piston H.P. 1/2

Capacity 4 G.P.M.

WELL TESTS:

Drawdown 4 ft. after _____ hours Pumping 10 G.P.M.

Drawdown _____ ft. after _____ hours _____ G.P.M.

USE OF WATER irrigation Temp. _____ °F., 19 _____

SOURCE OF INFORMATION GR-2788

DRILLER or DIGGER _____

ADDITIONAL DATA:

Log X Water Level Measurements _____ Chemical Analysis _____ Aquifer Test _____

REMARKS:

Clay 6
Sandstone 6 12