

STATE ENGINEER
Salem, Oregon

LANE Well Record

022463

STATE WELL NO. 20/3W-33P
COUNTY Lane
APPLICATION NO. GR-3011

OWNER: Earl Stewart (for Anne Stewart)

MAILING ADDRESS:

P.O. Box 474

LOCATION OF WELL: Owner's No.

CITY AND STATE:

Cottage Grove, Oregon

SE 1/4 SW 1/4 Sec. 33 T. 20 N. S. R. 3 E. W., W.M.

Bearing and distance from section or subdivision


corner 522' E. & 25' S. of SE Cor. Henry Small

DLC No. 57.

Altitude at well

TYPE OF WELL: drilled Date Constructed 1931

Depth drilled 470' Depth cased 40'

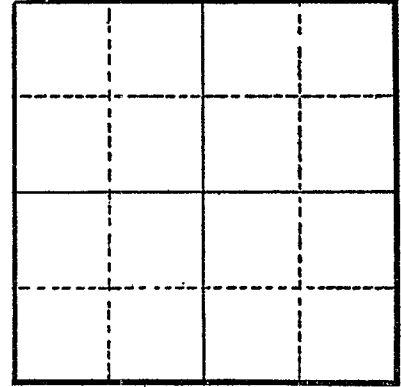

Section

CASING RECORD:

6 inch

2 inch

FINISH:

AQUIFERS:

WATER LEVEL:

12 feet

PUMPING EQUIPMENT: Type Fairbanks Morse

H.P. 3

Capacity 50 G.P.M.

WELL TESTS:

Drawdown 23 ft. after hours pumping 50 G.P.M.

Drawdown 18 ft. after hours pumping 45 G.P.M.

USE OF WATER irrigation & spraying water Temp. °F., 19

SOURCE OF INFORMATION GR-2819

DRILLER or DIGGER Original - Spears & Ralston, second - Art Moody

ADDITIONAL DATA:

Log Water Level Measurements Chemical Analysis Aquifer Test

REMARKS: