

STATE ENGINEER
Salem, Oregon

Well Record

LIANE

STATE WELL NO. 20/3W-34H
COUNTY Lane
APPLICATION NO. GR-1508

GR-1456

022512

OWNER: Ralph Plaisted

MAILING ADDRESS:

Rt. 1, Box 594


LOCATION OF WELL: Owner's No.

CITY AND STATE:

Cottage Grove, Oregon

SE $\frac{1}{4}$ NE $\frac{1}{4}$ Sec. 34 T. 20 S., R. 3 W., W.M.

Bearing and distance from section or subdivision corner 446' N. & 255' W. of E $\frac{1}{4}$ cor. Sec. 34.

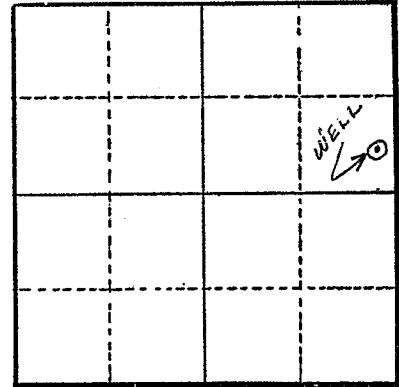

Section 34

Altitude at well 652'

TYPE OF WELL: Dug Date Constructed 1955

Depth drilled 9' Depth cased 9'

CASING RECORD:

36" cement septic tank blocks with mortar mix

FINISH:

AQUIFERS:

WATER LEVEL:

5' 10 $\frac{1}{2}$ "

PUMPING EQUIPMENT: Type Homart Cent. H.P. 1
Capacity 70 G.P.M.

WELL TESTS:

Drawdown 1/3 ft. after 81 hours G.P.M.
Drawdown ft. after hours G.P.M.

USE OF WATER Irrigation Temp. °F., 19

SOURCE OF INFORMATION GR Record

DRILLER or DIGGER

ADDITIONAL DATA:

Log Water Level Measurements Chemical Analysis Aquifer Test

REMARKS:

Log: Soil & rock 0 to 4 ft.
Sand & gravel 4 to 9 ft.

Irrigation of 2 acres.