

STATE ENGINEER
Salem, Oregon

LANE

Well Record

STATE WELL NO. 21/2-14A
COUNTY Lane
APPLICATION NO. GR-3610

023543

OWNER: Charles F. Tuhardt

MAILING

ADDRESS:

Star Route

CITY AND

STATE:


Westfir, Oregon

LOCATION OF WELL: Owner's No.

NE 1/4 NE 1/4 Sec. 14 T. 21 S. R. 2 E., W.M.

Bearing and distance from section or subdivision

corner 1180' S. & 525' W. from NE corner Sec. 14

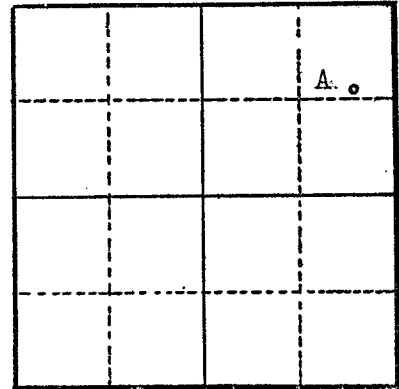

Altitude at well 1150'

TYPE OF WELL: Dug Date Constructed 7/10/55

Depth drilled 25' Depth cased

Section 14

CASING RECORD:

FINISH:

AQUIFERS:

WATER LEVEL:

10'

PUMPING EQUIPMENT: Type Homemart H.P. 1
Capacity 74 G.P.M.

WELL TESTS:

Drawdown 1/3 ft. after 25 hours G.P.M.

Drawdown ft. after hours G.P.M.

USE OF WATER Irrigation, Fire prot. Temp. °F. 19

SOURCE OF INFORMATION GR-3999

DRILLER or DIGGER

ADDITIONAL DATA:

Log NA Water Level Measurements Chemical Analysis Aquifer Test

REMARKS: