

STATE ENGINEER  
Salem, Oregon

# Well Record


**LANE**  
**023695**

STATE WELL NO. 21/3-16R  
COUNTY Lane  
APPLICATION NO. GR-3544

OWNER: Marion Hays  
MAILING ADDRESS: Box 3  
CITY AND STATE: Oakridge, Oregon

LOCATION OF WELL: Owner's No.  
SE 1/4 SE 1/4 Sec. 16 T. 21 N. S., R. 3 E., W.M.

Bearing and distance from section or subdivision  
corner 1000 feet North on East line commencing at SE Corner  
of Section 16, T. 21 S., R. 3 E., W. M.

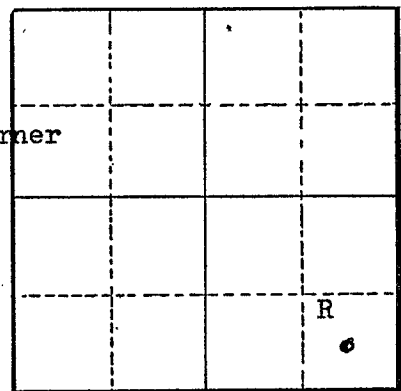

Altitude at well 1200 feet

TYPE OF WELL: Drilled Date Constructed July 1952

Depth drilled 38 feet Depth cased 38 feet

Section 16

### CASING RECORD:

5-inch casing set from 0 to 38 feet

### FINISH:

### AQUIFERS:

### WATER LEVEL:

23 feet

PUMPING EQUIPMENT: Type 1/2 HP Electric Jet H.P.  
Capacity 500 gph G.P.M.

### WELL TESTS:

Drawdown ft. after hours G.P.M.  
Drawdown ft. after hours G.P.M.

USE OF WATER Irrigation Temp. °F., 19

SOURCE OF INFORMATION GR-4063

DRILLER or DIGGER drilled by applicant

### ADDITIONAL DATA:

Log (NA) Water Level Measurements Chemical Analysis Aquifer Test

### REMARKS: