

MONITORING WELL REPORT

(as required by ORS 537.765 & OAR 690-240-095)

Instructions for completing this report are on the last page of this form

Well ID# L21541

Start Card # 105842

RECEIVED

MAR 19 1998

(1) OWNER/PROJECT: WELL NO.
Name Casey's Riverside Park
Address 46463 Westfir Rd.
City Westfir State OR Zip 97192


(6) LOCATION OF WELL By legal description
Well Location: County Lane
Well Location: County Lane Range 2E (E or W) Section 12
1/4 of SW 1/4 of above section.

(2) TYPE OF WORK:
[X] New construction [ ] Alteration (Repair/Recondition)
[ ] Conversion [ ] Deepening [ ] Abandonment

2. Either Street address of well location
behind same address
or Tax lot number of well location 500

(3) DRILLING METHOD
[X] Rotary Air [ ] Rotary Mud [ ] Cable
[ ] Hollow Stem Auger [ ] Other

(7) STATIC WATER LEVEL:
13 Ft. below land surface. Date 2-12-98
Artesian Pressure lb/sq. in. Date

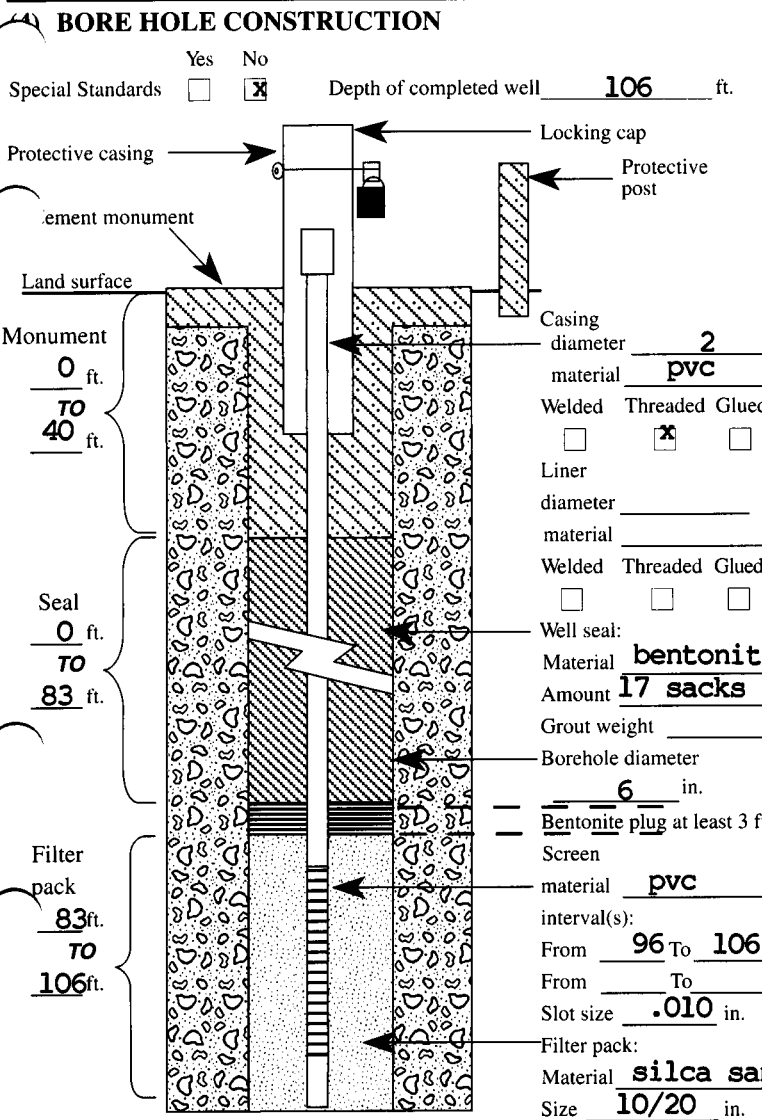


(8) WATER BEARING ZONES:
Table with columns: From, To, Est. Flow Rate, SWL. Data: 101-102, 15, 13

(9) WELL LOG:
Table with columns: Material, From, To, SWL. Data: topsoil (0-1), sand & gravel (1-32), blue brown white SS (32-106), 13

(5) WELL TEST:
[ ] Pump [ ] Bailer [X] Air [ ] Flowing Artesian
Permeability Yield 15 GPM
Conductivity PH
Temperature of water 56 F °F/C Depth artesian flow found ft.
Was water analysis done? [ ] Yes [X] No
By whom?
Depth of strata to be analyzed. From 99 ft. to 105 ft.
Remarks:
Name of supervising Geologist/Engineer

(unbonded) Monitor Well Constructor Certification:
I certify that the work I performed on the construction, alteration, or abandonment of this well is in compliance with Oregon well construction standards.
Signed: [Signature] MWC Number 1541 Date 2-16-98
(bonded) Monitor Well Constructor Certification:
I accept responsibility for the construction, alteration, or abandonment work performed on this well during the construction dates reported above.
Signed: [Signature] MWC Number 1541 Date 2-16-98

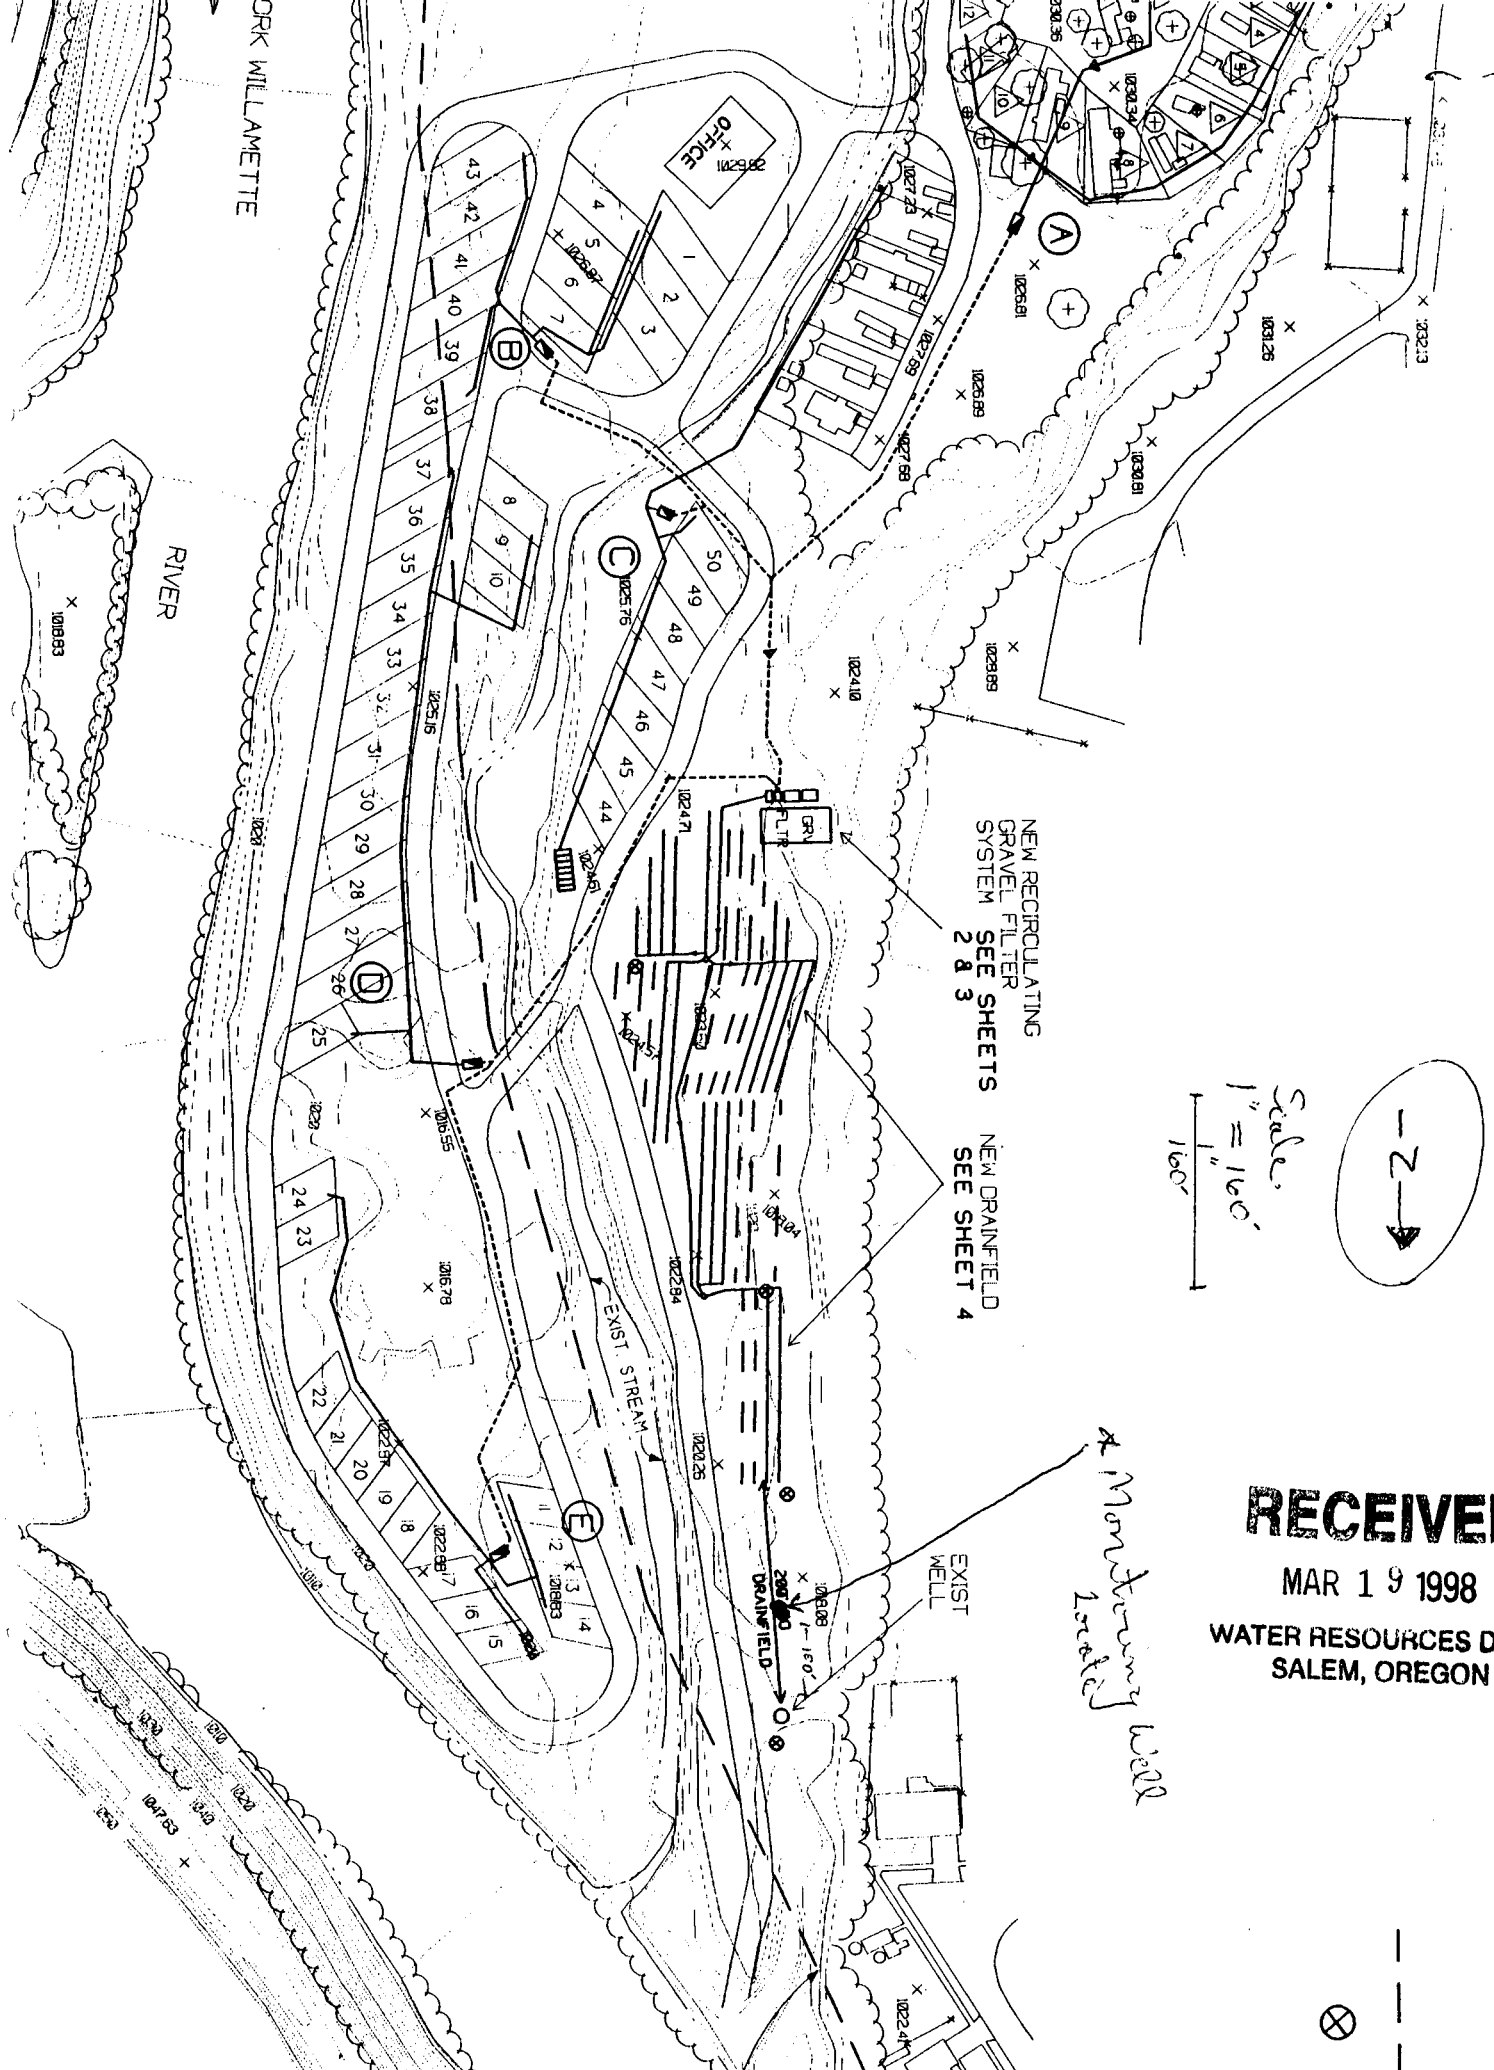

ORK WILLAMETTE

RIVER

OFFICE

NEW RECIRCULATING  
GRAVEL FILTER  
SYSTEM  
SEE SHEETS  
2 & 3

NEW DRAINFIELD  
SEE SHEET 4

EXIST STREAM

EXIST MOUND

EXIST WELL

MARKING WOOD



Scales  
1" = 160'

**RECEIVED**

MAR 19 1998

WATER RESOURCES DEPT  
SALEM, OREGON

