

LANE
5986


Well Record

OWNER: L. E. Wells MAILING ADDRESS: Route 3, Box 762

LOCATION OF WELL: Owner's No. Lot 16 Noraton CITY AND STATE: Junction City, Oregon

..... 1/4 1/4 Sec. 7 T. 15 S., R. 4 W., W.M.

Bearing and distance from section or subdivision corner 15 1/2 chains W. 40.06 chains S.

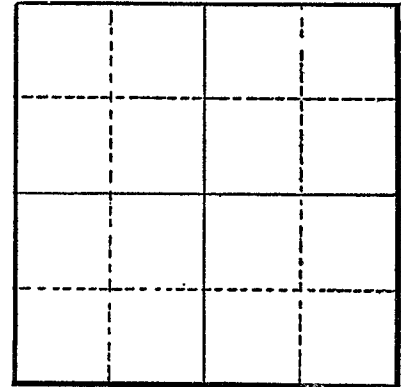

Section 7

Altitude at well

TYPE OF WELL: Driven Date Constructed 1950

Depth drilled 20 Depth cased 20

CASING RECORD:

3 inch

FINISH:

Slotted perforations from 18 1/2 to 20

AQUIFERS:

WATER LEVEL:

12 feet

PUMPING EQUIPMENT: Type Fairbanks Morse Centrifugal 1 1/2 H.P. 7 1/2
Capacity 150 G.P.M.

WELL TESTS:

Drawdown ft. after hours G.P.M.

Drawdown ft. after hours G.P.M.

USE OF WATER Irrigation Temp. °F. , 19

SOURCE OF INFORMATION GR-1911

DRILLER or DIGGER

ADDITIONAL DATA:

Log Water Level Measurements Chemical Analysis Aquifer Test

REMARKS: