

STATE ENGINEER
Salem, Oregon

LANE
5990

Well Record

STATE WELL NO. 15/4W-7G
COUNTY Lane
APPLICATION NO. GR-845

OWNER: Raymond Smith MAILING ADDRESS: Route 3

LOCATION OF WELL: Owner's No. #1 CITY AND STATE: Junction City, Oregon


SW 1/4 NE 1/4 Sec. 7 T. 15 S., R. 4 W., W.M.

Bearing and distance from section or subdivision corner 144' South & 390' W of SW

Altitude at well 340

TYPE OF WELL: Driven Date Constructed _____

Depth drilled 20 Depth cased 20

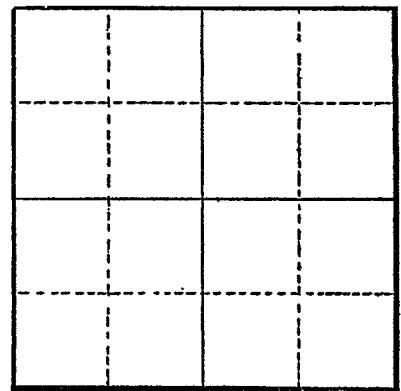

Section 7

CASING RECORD:

Three 3" pipes driven into grounding 3' triangle

FINISH:

AQUIFERS:

WATER LEVEL:

12'

PUMPING EQUIPMENT: Type Fairbanks Morse Centrifugal 3" H.P. 20 Elec.
Capacity 450 G.P.M.

WELL TESTS:

Drawdown 4 ft. after _____ hours 400 G.P.M.
Drawdown _____ ft. after _____ hours _____ G.P.M.

USE OF WATER Irrigation Temp. _____ °F. _____, 19

SOURCE OF INFORMATION Owner

DRILLER or DIGGER _____

ADDITIONAL DATA:
Log NA Water Level Measurements _____ Chemical Analysis _____ Aquifer Test _____

REMARKS: