

STATE ENGINEER
Salem, Oregon

Well Record

STATE WELL NO. 15/LW-7J
COUNTY Lane
APPLICATION NO. GR-1619

LANE
5991


GR- 1577

OWNER: Clarence L. & Edna M. Briggs MAILING ADDRESS: Rt. 3

LOCATION OF WELL: Owner's No. #1 CITY AND STATE: Junction City, Oregon

NE 1/4 SE 1/4 Sec. 7 T. 15 N. S. R. 4 W., W.M.

Bearing and distance from section or subdivision corner 30 ch. N. & 16.5 ch. W. from SE cor. Sec. 7

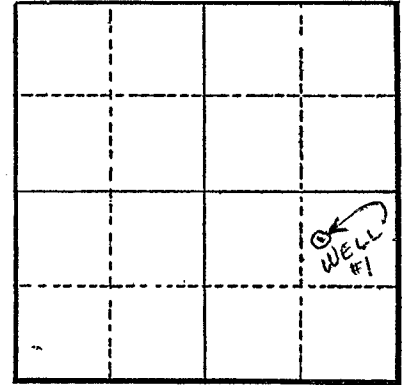

Section 7

Altitude at well 300'

TYPE OF WELL: Driven Date Constructed 1950

Depth drilled 30' Depth cased 30'

~~FINISH~~ FINISH:
12 4" x 1/2" slots per foot six ft. from point.

~~FINISH~~ CASING RECORD:
3 - 4" pipe

AQUIFERS:

WATER LEVEL:
10 ft.

PUMPING EQUIPMENT: Type F. M. 4" H.P. 50
Capacity 850 G.P.M.

WELL TESTS:
Drawdown ft. after hours G.P.M.
Drawdown ft. after hours G.P.M.

USE OF WATER Irrigation Temp. °F. 19

SOURCE OF INFORMATION GR Record

DRILLER or DIGGER

ADDITIONAL DATA:
Log N.A. Water Level Measurements Chemical Analysis Aquifer Test

REMARKS:
Irrigation of 23.4 acres.