

STATE ENGINEER
Salem, Oregon

LANE
5993

Well Record

STATE WELL NO. 15/4W-70
COUNTY Lane
APPLICATION NO. GR-1620


GR- 1578

OWNER: Clarence L. & Edna M. Briggs MAILING ADDRESS: Rt. 3

LOCATION OF WELL: Owner's No. #2 CITY AND STATE: Junction City, Oregon

SW 1/4 SE 1/4 Sec. 7 T. 15 S., R. 4 W., W.M.

Bearing and distance from section or subdivision corner 45' N. & 1330' W. from SE cor. Sec. 7

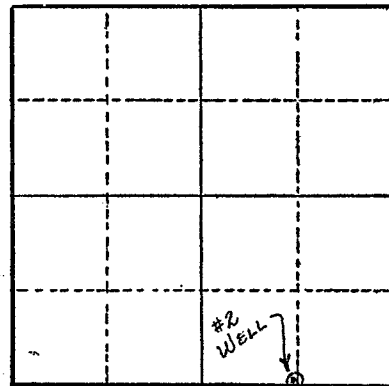

Section 7

Altitude at well 300'

TYPE OF WELL: Drilled Date Constructed 1953

Depth drilled 30' Depth cased ?

CASING RECORD:
10"

FINISH:

AQUIFERS:

WATER LEVEL:
6'

PUMPING EQUIPMENT: Type F. M. 4" H.P. 50
Capacity 850 G.P.M.

WELL TESTS:
Drawdown 12 ft. after hours 850 G.P.M.
Drawdown ft. after hours G.P.M.

USE OF WATER Irrigation Temp. °F. 19

SOURCE OF INFORMATION GR Record

DRILLER or DIGGER

ADDITIONAL DATA:
Log Water Level Measurements Chemical Analysis Aquifer Test

REMARKS:

Log: Top soil 0 to 6 ft.
Gravel 6 to 30 ft.

Irrigation of 31.7 acres.