

STATE ENGINEER
Salem, Oregon

LANE
5994

Well Record

STATE WELL NO. 15/LW - 7R
COUNTY LANE
APPLICATION NO. GR-2135

OWNER: Robert L. Leabo


MAILING ADDRESS: Rt. 3, Box 916

LOCATION OF WELL: Owner's No.

CITY AND STATE: Junction City, Oregon

SE 1/4 SE 1/4 Sec. 7 T. 15 N. 4 W., W.M.

Bearing and distance from section or subdivision corner 500' N and 300' W.

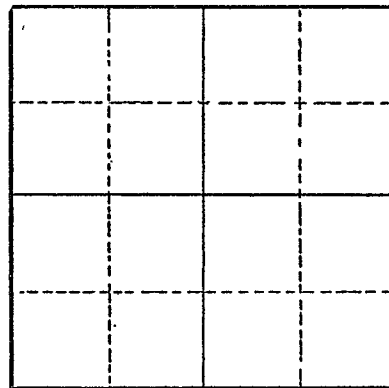

Section

Altitude at well

TYPE OF WELL: Driven Date Constructed 1943

Depth drilled 20 Depth cased 20

CASING RECORD:

5-Inch

FINISH:

AQUIFERS:

WATER LEVEL:

8-feet

PUMPING EQUIPMENT: Type Centrifugal H.P. 10
Capacity 300 G.P.M.

WELL TESTS:

Drawdown ft. after hours G.P.M.
Drawdown ft. after hours G.P.M.

USE OF WATER Irrigation Temp. °F., 19

SOURCE OF INFORMATION GR-2048

DRILLER or DIGGER

ADDITIONAL DATA:

Log Water Level Measurements Chemical Analysis Aquifer Test

REMARKS: