

STATE ENGINEER
Salem, Oregon

LANE
6000

Well Record


STATE WELL NO. 15/4W-8K
COUNTY Lane
APPLICATION NO. GR-4046

OWNER: Helen A. Jack
MAILING ADDRESS: Route 3

LOCATION OF WELL: Owner's No. _____
CITY AND STATE: Junction City, Oregon

NW 1/4 SE 1/4 Sec. 8 T. 15 S., R. 4 W., W.M.

Bearing and distance from section or subdivision
corner 1825' N. & 1975' E. from SW Cor. Sec. 8

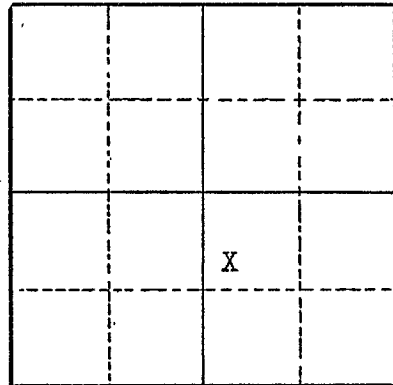

Section 8

Altitude at well _____

TYPE OF WELL: Driven Date Constructed 6/50

Depth drilled 25 ft. Depth cased 25 ft.

CASING RECORD:

4 inch well casing set to 25 feet

FINISH:

36" of perforations on end from 22 to 25 feet

AQUIFERS:

WATER LEVEL:

12 feet below surface

PUMPING EQUIPMENT: Type Fairbanks Morse 2" intake 1 1/2" outlet H.P. 7 1/2
Capacity 124 G.P.M.

WELL TESTS:

Drawdown 2 ft. after _____ hours 200 G.P.M.

Drawdown _____ ft. after _____ hours _____ G.P.M.

USE OF WATER Irrigation Temp. _____ °F., 19

SOURCE OF INFORMATION Well Registration Statement Cert. # GR-3647

DRILLER or DIGGER _____

ADDITIONAL DATA:

Log Water Level Measurements _____ Chemical Analysis _____ Aquifer Test _____

REMARKS:

Log: 10 ft. light loam and small gravel to coarse water bearing gravel.