

STATE ENGINEER
Salem, Oregon

LANE
6001

Well Record

STATE WELL NO. 15/LW-8K
COUNTY Lane
APPLICATION NO. GR-3125

OWNER: Frank Gates


MAILING ADDRESS: Route 3

LOCATION OF WELL: Owner's No.

CITY AND STATE: Junction City, Oregon

NW 1/4 SE 1/4 Sec. 8 T. 15 S., R. 4 W., W.M.

Bearing and distance from section or subdivision corner 3150' E. and 1800' N.

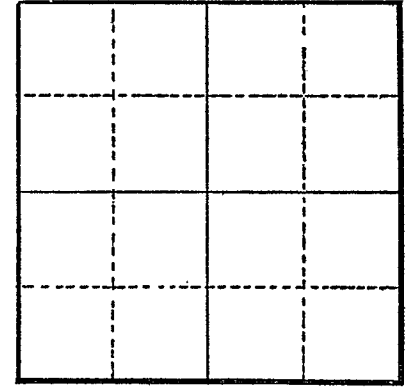

Section

Altitude at well

TYPE OF WELL: Driven Date Constructed 1948

Depth drilled 24' Depth cased 24'

CASING RECORD:

4"

FINISH:

3' of 4" regular perforated casing from 21 to 24

AQUIFERS: Gravel
Loam
Sand & Gravel

WATER LEVEL:

12'

PUMPING EQUIPMENT: Type Fairbanks Morse H.P. 15
Capacity 200 G.P.M.

WELL TESTS:

Drawdown 2 ft. after pumping 250 G.P.M.
Drawdown ft. after hours G.P.M.

USE OF WATER Irrigation Temp. °F., 19
SOURCE OF INFORMATION GR-2932

DRILLER or DIGGER

ADDITIONAL DATA:

Log ^x Water Level Measurements Chemical Analysis Aquifer Test

REMARKS: Loam 2 2
Sand & Gravel 10 12
Gravel 12 24