

STATE ENGINEER  
Salem, Oregon

LANE  
6003

# Well Record

STATE WELL NO. 15/LW-8L  
COUNTY Lane  
APPLICATION NO. GR-3126

OWNER: Frank Gates


MAILING ADDRESS: Route 3

LOCATION OF WELL: Owner's No. #2

CITY AND STATE: Junction City, Oregon

NE 1/4 SW 1/4 Sec. 8 T. 15 S., R. 4 W., W.M.

Bearing and distance from section or subdivision corner 2540' N. and 1250' E.

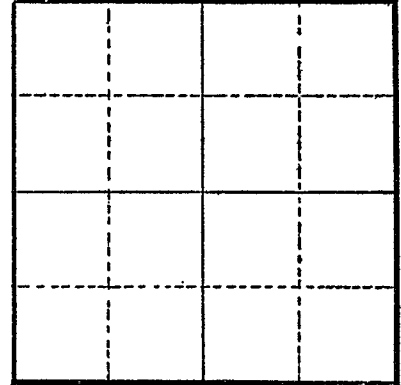

Section

Altitude at well

TYPE OF WELL: Driven Date Constructed 1952

Depth drilled 27' Depth cased 27'

### CASING RECORD:

5"

### FINISH:

5' of 5" casing with cut perforations from 22 to 27

AQUIFERS: Silt Loam  
Fine sand  
Gravel

### WATER LEVEL:

12'

PUMPING EQUIPMENT: Type Fairbanks Morse H.P. 15  
Capacity 200 G.P.M.

### WELL TESTS:

Drawdown 2 ft. after pumping 280 hours G.P.M.  
Drawdown ft. after hours G.P.M.

USE OF WATER Irrigation Temp. °F., 19

SOURCE OF INFORMATION GR-2933

DRILLER or DIGGER

### ADDITIONAL DATA:

Log  Water Level Measurements  Chemical Analysis  Aquifer Test

### REMARKS:

Silt Loam 8 8  
Fine Sand 2 10  
Sand & Gravel 17 27