

STATE ENGINEER
Salem, Oregon

LANE
6004

Well Record

STATE WELL NO. 15/4W-8M
COUNTY Lane
APPLICATION NO. GR-3081

OWNER: L. M. Talbott


MAILING ADDRESS: Route 3

LOCATION OF WELL: Owner's No.

CITY AND STATE: Junction City, Oregon

NW 1/4 SW 1/4 Sec. 8 T. 15 S., R. 4 W., W.M.

Bearing and distance from section or subdivision corner 2560 ft. N. & 1230 ft. E.

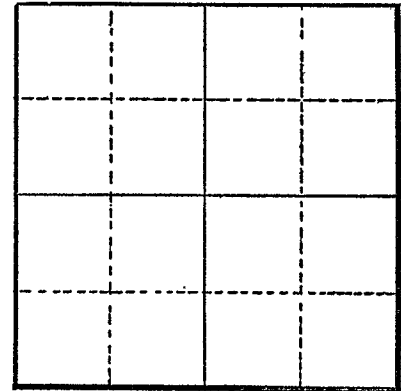

Section

Altitude at well

TYPE OF WELL: Driven Date Constructed 1944

Depth drilled 22 feet Depth cased 22 feet

CASING RECORD:

4-inch

FINISH:

Standard perforations from 19 to 22

AQUIFERS:

Top soil, Sand, & Gravel

WATER LEVEL:

11 feet

PUMPING EQUIPMENT: Type Berkeley Centrifugal - 3" H.P. 15
Capacity 525 G.P.M.

WELL TESTS:

Drawdown	2	ft. after	hours	Pumping 525	G.P.M.
Drawdown	ft. after	hours	G.P.M.

USE OF WATER Irrigation Temp. °F. 19

SOURCE OF INFORMATION GR-2887

DRILLER or DIGGER

ADDITIONAL DATA:

Log Water Level Measurements Chemical Analysis Aquifer Test

REMARKS:

Top soil (loam)	4	18
Sand & gravel	18	0