

STATE ENGINEER
Salem, Oregon

Well Record

STATE WELL NO. 15/4W-8P
COUNTY Lane
APPLICATION NO. GR-4174


*LANE
0006*

OWNER: Roscoe B. Paine MAILING ADDRESS: 80 Talbot Lane

LOCATION OF WELL: Owner's No. # 1 CITY AND STATE: Junction City, Oregon

SE 1/4 SW 1/4 Sec. 8 T. 15 N. S., R. 4 E. W., W.M.

Bearing and distance from section or subdivision corner 12 chains North and 45 Chains West from SE Corner, Section 8

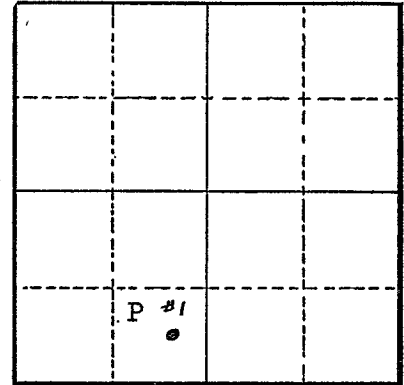

Section 8

Altitude at well 300 feet

TYPE OF WELL: Driven Date Constructed 1945

Depth drilled 30 feet Depth cased 30 feet

CASING RECORD:

5 inch casing set from 0 to 30 feet

FINISH:

Perforated 1/2 in. from 25 to 30 feet

AQUIFERS:

silt, gravel, and sand

WATER LEVEL:

PUMPING EQUIPMENT: Type Pacific 4 x 3 H.P.
Capacity 360 G.P.M.

WELL TESTS:

Drawdown 15 ft. after 450 hours G.P.M.

Drawdown ft. after hours G.P.M.

USE OF WATER Irrigation Temp. °F., 19

SOURCE OF INFORMATION GR-4067

DRILLER or DIGGER

ADDITIONAL DATA:

Log x Water Level Measurements Chemical Analysis Aquifer Test

REMARKS:

silt	8	8
gravel	5	13
sand	12	25
gravel	5	30