

STATE ENGINEER
Salem, Oregon

LANE
6007

Well Record


STATE WELL NO. 15S/4W-8P
COUNTY Lane
APPLICATION NO. GR-4176

OWNER: Roscoe B. Paine MAILING ADDRESS: 80 Talbot Lane

LOCATION OF WELL: Owner's No. # 2 CITY AND STATE: Junction City, Oregon

SE 1/4 SW 1/4 Sec. 8 T. 15 N. S., R. 4 E. W., W.M.

Bearing and distance from section or subdivision corner 12 chains North and 57 chains West from the SE Corner, Section 8

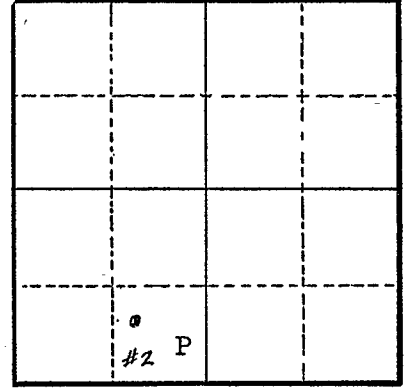

Section 8

Altitude at well 300 feet

TYPE OF WELL: Driven Date Constructed unk

Depth drilled 35 feet Depth cased 35 feet

CASING RECORD:

5-inch casing set from 0 to 35 feet

FINISH:

Perforated 1/2 in. 30 to 35 feet

AQUIFERS:

gravel and sand

WATER LEVEL:

21 feet

PUMPING EQUIPMENT: Type Berkeley 4 x 3 H.P.
Capacity 300 G.P.M.

WELL TESTS:

Drawdown 15 ft. after 350 hours G.P.M.
Drawdown ft. after hours G.P.M.

USE OF WATER Irrigation Temp. °F., 19

SOURCE OF INFORMATION GR-4069

DRILLER or DIGGER

ADDITIONAL DATA:

Log Water Level Measurements Chemical Analysis Aquifer Test

REMARKS:

gravel and sand	8	8
silt	5	13
sand gravel	5	18
gravel	14	32