

STATE ENGINEER
Salem, Oregon

LANE
6008

Well Record

STATE WELL NO. 15/4W-8Q
COUNTY Lane
APPLICATION NO. GR-4175

OWNER: Roscoe B. Paine


MAILING ADDRESS: 80 Talbot Lane

LOCATION OF WELL: Owner's No. # 3

CITY AND STATE: Junction City, Oregon

SW 1/4 SE 1/4 Sec. 8 T. 15 S., R. 4 W., W.M.

Bearing and distance from section or subdivision
corner 12 chains North and 31 chains West from
the SE Corner, Section 8

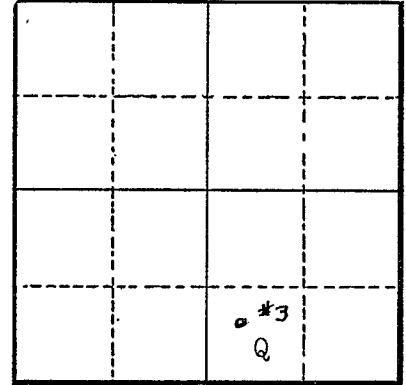

Section 8

Altitude at well 300 feet

TYPE OF WELL: Driven Date Constructed 1950

Depth drilled 30 feet Depth cased 30 feet

CASING RECORD:

4-inch casing set from 0 to 30 feet

FINISH:

Perforated 1/2 in. slots from 25 to 30 feet

AQUIFERS:

silt, gravel, and sand

WATER LEVEL:

PUMPING EQUIPMENT: Type Pacific H.P.
Capacity 400 G.P.M.

WELL TESTS:

Drawdown 15 ft. after 450 hours G.P.M.

Drawdown ft. after hours G.P.M.

USE OF WATER Irrigation Temp. °F., 19

SOURCE OF INFORMATION GR-4068

DRILLER or DIGGER

ADDITIONAL DATA:

Log Water Level Measurements Chemical Analysis Aquifer Test

REMARKS:

silt	8	8
gravel	3	11
silt	10	21
sand	5	26
gravel	4	30