

STATE ENGINEER
Salem, Oregon

LANE
6009

Well Record

STATE WELL NO. 15/4W-8Q(1)
COUNTY Lane
APPLICATION NO. GR-1007

Gr- 973

OWNER: Walter & Andrea Nielsen


MAILING ADDRESS: Rt. 3

LOCATION OF WELL: Owner's No. #1

CITY AND STATE: Junction City, Oregon

SW 1/4 SE 1/4 Sec. 8 T. 15 S., R. 4 W., W.M.

Bearing and distance from section or subdivision corner 24.2 ch. W. from SE cor. Sec. 8.

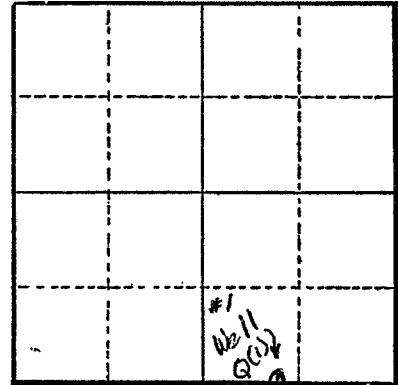

Section 8

Altitude at well 320 ft.

TYPE OF WELL: Driven Date Constructed 1954

Depth drilled 22 ft. Depth cased 22 ft.

CASING RECORD:

4 inch

FINISH:

AQUIFERS:

WATER LEVEL:

14 ft.

PUMPING EQUIPMENT: Type Cornell 2 1/2 in. H.P. 10
Capacity 300 G.P.M.

WELL TESTS:

Drawdown ft. after hours G.P.M.

Drawdown ft. after hours G.P.M.

USE OF WATER Irrigation Temp. °F., 19

SOURCE OF INFORMATION G.R. Record

DRILLER or DIGGER

ADDITIONAL DATA:

Log N.A. Water Level Measurements Chemical Analysis Aquifer Test

REMARKS:

Irrigation of 28 acres.