

STATE ENGINEER
Salem, Oregon

LANE
6015

Well Record


STATE WELL NO. 15/4W-9M
COUNTY Lane
APPLICATION NO. GR-4102

OWNER: Leon Jerome Bryson
MAILING ADDRESS: 102 Lingo Lane

LOCATION OF WELL: Owner's No. _____
CITY AND STATE: Junction City, Oregon

NW 1/4 SW 1/4 Sec. 9 T. 15 N. S. R. 4 W., W.M.

Bearing and distance from section or subdivision
corner 1800 feet North and 500 feet East of the
Southwest corner, Section 9

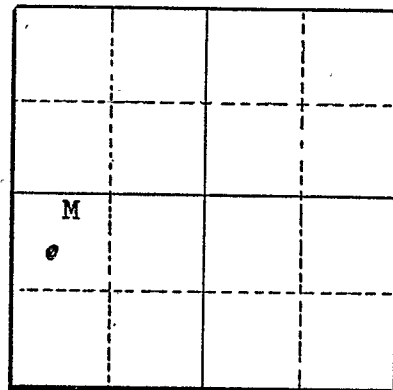

Section 9

Altitude at well 300 feet

TYPE OF WELL: Drilled Date Constructed June 1953

Depth drilled 20 feet Depth cased _____

CASING RECORD:

FINISH:

AQUIFERS:

WATER LEVEL:

16 feet

PUMPING EQUIPMENT: Type Rain Flow 3in. H.P.
Capacity 385 G.P.M.

WELL TESTS:

Drawdown 1 ft. after _____ hours 384 G.P.M.

Drawdown _____ ft. after _____ hours _____ G.P.M.

USE OF WATER Irrigation Temp. _____ °F. _____, 19

SOURCE OF INFORMATION GR-4054

DRILLER or DIGGER Raymond K. Baker Albany, Oregon

ADDITIONAL DATA:

Log (NA) Water Level Measurements _____ Chemical Analysis _____ Aquifer Test _____

REMARKS: