

STATE ENGINEER
Salem, Oregon

LANE
6053

Well Record

STATE WELL NO. 15/4W - 17A
COUNTY LANE
APPLICATION NO. GR-2092

OWNER: B. F. Ross


MAILING ADDRESS: Route 1

LOCATION OF WELL: Owner's No.

CITY AND STATE: Harrisburg, Oregon

NE 1/4 NE 1/4 Sec. 17 T. 15 N. 4 E. S., R. W., W.M.

Bearing and distance from section or subdivision corner 1175' S. & 400' W.

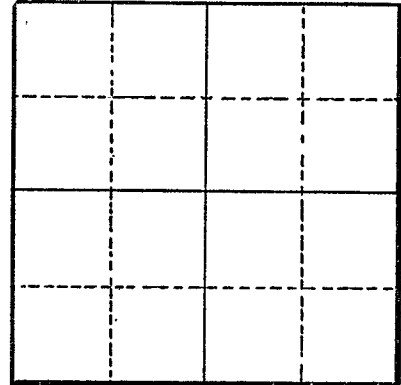

Section

Altitude at well

TYPE OF WELL: Driven Date Constructed 1950

Depth drilled 20 Depth cased 20

CASING RECORD:

4-inch

FINISH:

Perforations from 18 to 20

AQUIFERS:

Loam and coarse gravel

WATER LEVEL:

10-feet

PUMPING EQUIPMENT: Type Pirtle Centrifugal H.P. 30
Capacity 150 G.P.M.

WELL TESTS:

Drawdown 2 ft. after hours Pumping 250 G.P.M.
Drawdown ft. after hours G.P.M.

USE OF WATER Irrigation Temp. °F. 19

SOURCE OF INFORMATION GR-2009

DRILLER or DIGGER

ADDITIONAL DATA:

Log Water Level Measurements Chemical Analysis Aquifer Test

REMARKS:

Loam (Top Soil) 8' 12'
Coarse gravel 12' 0'