

LANE
6054

Well Record

OWNER: Max Nielsen


MAILING ADDRESS: Route 3

LOCATION OF WELL: Owner's No.

CITY AND STATE: Junction City, Oregon

NW 1/4 NE 1/4 Sec. 17 T. 15 S., R. 4 W., W.M.

Bearing and distance from section or subdivision corner 910' S. & 2900' E. of NW Cor. Sec. 17

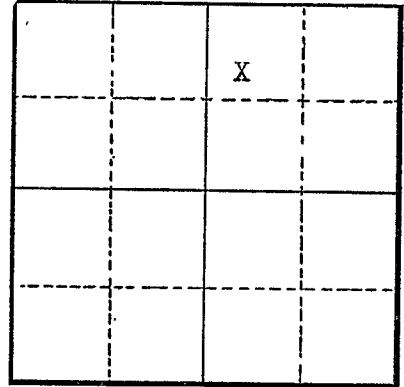

Section 17

Altitude at well

TYPE OF WELL: Driven Date Constructed 1/51

Depth drilled 22 ft. Depth cased 22 ft.

CASING RECORD:

4 inch regular steel well pipe to 22 feet

FINISH:

4' of 4" regular perforated well casing from 18 to 22 feet

AQUIFERS:

WATER LEVEL:

12 feet below surface

PUMPING EQUIPMENT: Type Pacific centrifugal 2" H.P. 10
Capacity 250 G.P.M.

WELL TESTS:

Drawdown	2	ft. after	hours	400	G.P.M.
Drawdown		ft. after	hours		G.P.M.

USE OF WATER Irrigation Temp. °F. 19

SOURCE OF INFORMATION Well Registration Statement Cert. # GR-3637

DRILLER or DIGGER

ADDITIONAL DATA:

Log Water Level Measurements Chemical Analysis Aquifer Test

REMARKS:

Log:

	Thickness	Depth to Bottom
Silt loam	6	6
Sand	4	10
Sand & gravel	12	22