


LANE
6055

Well Record

OWNER: R. C. Betterton
MAILING ADDRESS: Rt. 3

LOCATION OF WELL: Owner's No. 1
CITY AND STATE: Junction City, Oregon

NW 1/4 NE 1/4 Sec. 17 T. 15 S., R. 4 W., W.M.
Bearing and distance from section or subdivision
corner W. 2204.4 ft. & S. 198.3 ft. from NE cor.
Sec. 17

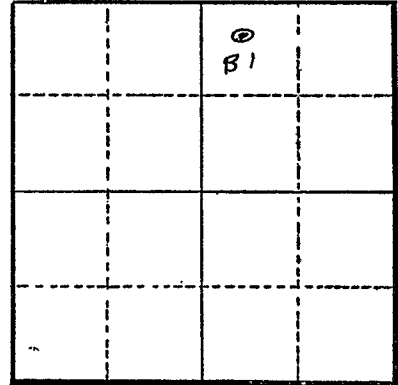

Section 17

Altitude at well 305 ft. Interpolated

TYPE OF WELL: driven Date Constructed 1942
Depth drilled 22 Depth cased 22

CASING RECORD: 3 inch pipe driven from 0 to 22 ft.

FINISH: unknown

AQUIFERS: unknown

WATER LEVEL: 14 ft. below land surface

PUMPING EQUIPMENT: Type centrifugal H.P. 25 tractor
Capacity 250 G.P.M.

WELL TESTS:
Drawdown ft. after hours G.P.M.
Drawdown ft. after hours G.P.M.

USE OF WATER irrigation 5.3 acres Temp. °F., 19
SOURCE OF INFORMATION Registration Statement GR-312

DRILLER or DIGGER
ADDITIONAL DATA:
Log No Water Level Measurements Chemical Analysis Aquifer Test

REMARKS: