


LANE
6058

Well Record

OWNER: Wallis D. and Hulda M. Smith MAILING ADDRESS: Route 3

LOCATION OF WELL: Owner's No. CITY AND STATE: Junction City, Oregon

NW 1/4 NW 1/4 Sec. 17 T. 15 N. S. R. 4 W., W.M.
Bearing and distance from section or subdivision
corner 660' S. and 1035' E.

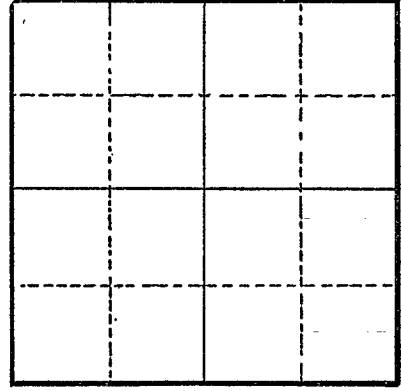

Section

Altitude at well

TYPE OF WELL: driven Date Constructed 1943
Depth drilled 22 Depth cased 22

CASING RECORD:

4-inch

FINISH:

Standard perforation from 19 to 22

AQUIFERS:

Topsoil, sand and gravel

WATER LEVEL:

12-feet

PUMPING EQUIPMENT: Type Fairbanks Morse Centrifugal H.P. 10
Capacity 350 G.P.M.

WELL TESTS:

Drawdown 2 ft. after hours Pumping 300 G.P.M.
Drawdown ft. after hours G.P.M.

USE OF WATER Irrigation Temp. °F., 19

SOURCE OF INFORMATION GR-2675

DRILLER or DIGGER

ADDITIONAL DATA:

Log X Water Level Measurements Chemical Analysis Aquifer Test

REMARKS:

Topsoil (Loam) 4 18
Sand and gravel 18 0