

STATE ENGINEER
Salem, Oregon

Well Record

STATE WELL NO. 15/4W-17E(1)
COUNTY Lane
APPLICATION NO. GR-699

LANE
6059

OWNER: Ed. LeRoy Adams


MAILING ADDRESS: Rt. 3

LOCATION OF WELL: Owner's No. 2

CITY AND STATE: Junction City, Oregon

SW 1/4 NW 1/4 Sec. 17 T. 15 ^N S., R. 4 ^E W., W.M.

Bearing and distance from section or subdivision corner 1900' S. & 693' E. from NW cor. Sec. 17

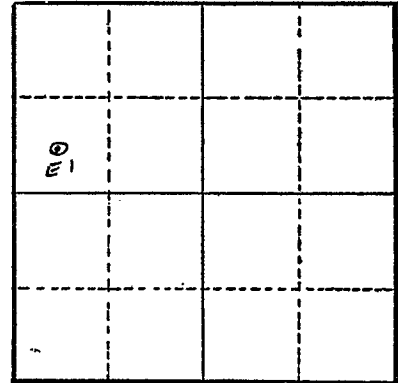

Section 17

Altitude at well 300' Interpolated

TYPE OF WELL: drilled Date Constructed May, 1951

Depth drilled 29 ft. Depth cased 29 ft.

CASING RECORD: 6 inch

FINISH:

AQUIFERS:

WATER LEVEL: 12 ft.

PUMPING EQUIPMENT: Type Pacific H.P. 15
Capacity 300 G.P.M.

WELL TESTS:

Drawdown ft. after hours G.P.M.

Drawdown ft. after hours G.P.M.

USE OF WATER irrigation 21 acres Temp. °F., 19

SOURCE OF INFORMATION GR-699

DRILLER or DIGGER Evertt Scott, Harrisburg, Oregon

ADDITIONAL DATA:

Log Water Level Measurements Chemical Analysis Aquifer Test

REMARKS: