

STATE ENGINEER  
Salem, Oregon

# Well Record


STATE WELL NO. 15/4W-17F(1)  
COUNTY Lane  
APPLICATION NO. GR-177

*LANE*  
*60067*

OWNER: Roy C. Betterton  
MAILING ADDRESS: Rt. 3

LOCATION OF WELL: Owner's No. 2  
CITY AND STATE: Junction City, Oregon

SE 1/4 NW 1/4 Sec. 17 T. 15 N S., R. 4 W., W.M.  
Bearing and distance from section or subdivision  
corner 3044.4' W. & 1910' S. from NE cor. Sec. 17

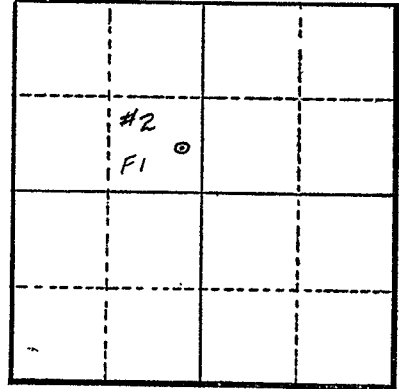

Section 17

Altitude at well 325 ft. Interpolated

TYPE OF WELL: driven Date Constructed 1952

Depth drilled 22 ft. Depth cased 22 ft.

CASING RECORD: 4 inch pipe driven to 22 ft.

FINISH: unknown

AQUIFERS: unknown

WATER LEVEL: 14 ft. below land surface

PUMPING EQUIPMENT: Type centrifugal H.P. 25 tractor  
Capacity 250 G.P.M.

WELL TESTS:  
Drawdown ..... ft. after ..... hours ..... G.P.M.  
Drawdown ..... ft. after ..... hours ..... G.P.M.

USE OF WATER irrigation 6.1 acres Temp. °F. , 19  
SOURCE OF INFORMATION Reg. Statement GR-177

DRILLER or DIGGER .....  
ADDITIONAL DATA:  
Log No Water Level Measurements ..... Chemical Analysis ..... Aquifer Test .....

REMARKS: