

STATE ENGINEER
Salem, Oregon

LANE
0062

Well Record

STATE WELL NO. 15/4W-17F
COUNTY Lane
APPLICATION NO. GR-2363

OWNER: John W. Moode

MAILING ADDRESS: Rt. 3, Box 812


LOCATION OF WELL: Owner's No.

CITY AND STATE: Junction City, Oregon

SE 1/4 NW 1/4 Sec. 17 T. 15 S., R. 4 W., W.M.

Bearing and distance from section or subdivision

corner 1820' E. 3500' N.

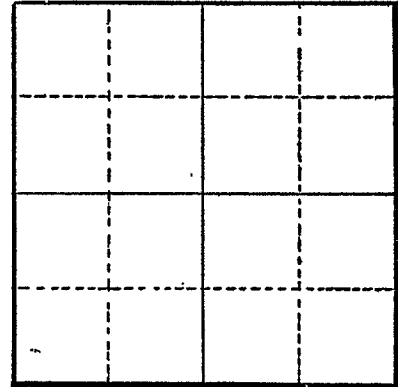

Section

Altitude at well

TYPE OF WELL: driven Date Constructed 1949

Depth drilled 21 Depth cased 21

CASING RECORD: 4 inch

FINISH: Perforations from 18 to 21 feet

AQUIFERS: Loam, sand & gravel

WATER LEVEL: 12 ft.

PUMPING EQUIPMENT: Type Peerless centrifugal H.P. 3
Capacity 80 G.P.M.

WELL TESTS:
Drawdown 2 ft. after hours pumping 250 G.P.M.
Drawdown ft. after hours G.P.M.

USE OF WATER irrigation Temp. °F., 19

SOURCE OF INFORMATION GR-2245

DRILLER or DIGGER

ADDITIONAL DATA:

Log Water Level Measurements Chemical Analysis Aquifer Test

REMARKS: Loam 4 - 17 ft.
Sand & coarse gravel 17 - 0 ft.