

STATE ENGINEER
Salem, Oregon

Well Record

STATE WELL NO. 15/4W-17E(2)
COUNTY Lane
APPLICATION NO. GR-1226

LANE
60063

GR- 1185

OWNER: Frank K. Hayes

MAILING

ADDRESS: 330 River Rd.

LOCATION OF WELL: Owner's No.


CITY AND

STATE: Junction City, Oregon

SE 1/4 NW 1/4 Sec. 17 T. 15 S., R. 4 W., W.M.

Bearing and distance from section or subdivision

corner 550' W. & 150' N. from Center of Sec. 17.

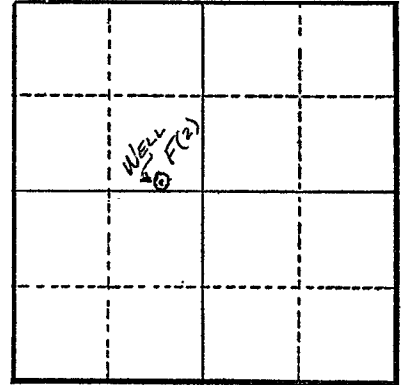

Section 17

Altitude at well 310 ft.

TYPE OF WELL: Driven Date Constructed 1940

Depth drilled 30 ft. Depth cased 30 ft.

CASING RECORD:

4 in.

FINISH:

AQUIFERS:

WATER LEVEL:

PUMPING EQUIPMENT: Type Berkeley Cent. H.P. 10
Capacity 180 G.P.M.

WELL TESTS:

Drawdown ft. after hours G.P.M.

Drawdown ft. after hours G.P.M.

USE OF WATER Irrigation Temp. °F. 19

SOURCE OF INFORMATION G. R. Record

DRILLER or DIGGER

ADDITIONAL DATA:

Log N.A. Water Level Measurements Chemical Analysis Aquifer Test

REMARKS:

Log: Gravel

Irrigation of 41 acres.