

STATE ENGINEER
Salem, Oregon

Well Record

STATE WELL NO. 15/4W-17G
COUNTY Lane
APPLICATION NO. GR-4032

LANE
6064

OWNER: Max Nielsen


MAILING ADDRESS: Route 3

LOCATION OF WELL: Owner's No. _____

CITY AND STATE: Junction City, Oregon

SW $\frac{1}{4}$ NE $\frac{1}{4}$ Sec. 17 T. 15 S., R. 4 N. E. W., W.M.

Bearing and distance from section or subdivision corner 1940' S. & 2870' E. of NW Cor. Sec. 17

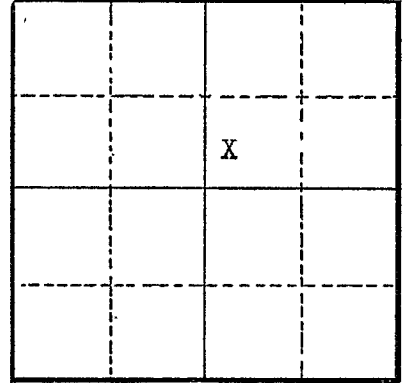

Section 17

Altitude at well _____

TYPE OF WELL: Driven Date Constructed 1950

Depth drilled 23 ft. Depth cased 23 ft.

CASING RECORD:

4 inch regular steel well pipe set to 23 feet

FINISH:

4' of 4" regular perforated well casing from 19 to 23 feet

AQUIFERS:

WATER LEVEL:

PUMPING EQUIPMENT: Type 3" H.P. 15
Capacity 400 G.P.M.

WELL TESTS:

Drawdown 2 ft. after _____ hours 400 G.P.M.

Drawdown _____ ft. after _____ hours _____ G.P.M.

USE OF WATER Irrigation Temp. _____ °F., 19 _____

SOURCE OF INFORMATION Well Registration Statement Cert. # GR-3635

DRILLER or DIGGER _____

ADDITIONAL DATA:

Log Water Level Measurements _____ Chemical Analysis _____ Aquifer Test _____

REMARKS:

Log:	Thickness	Depth to Bottom
Silt loam	10	10
Sand	6	16
Sand & gravel	7	23