

STATE ENGINEER
Salem, Oregon

LANE
0065

Well Record


STATE WELL NO. 15/4W-17G(1)
COUNTY Lane
APPLICATION NO. GR-1011

GR- 977

OWNER: Walter & Andrea Nielsen Mailing ADDRESS: Rt. 3

LOCATION OF WELL: Owner's No. #5 CITY AND STATE: Junction City, Oregon

SW 1/4 NE 1/4 Sec. 17 T. 15 S., R. 4 W., W.M.
Bearing and distance from section or subdivision
corner 30.8 ch. & 20.5 ch. S. of NE cor. Sec. 17.

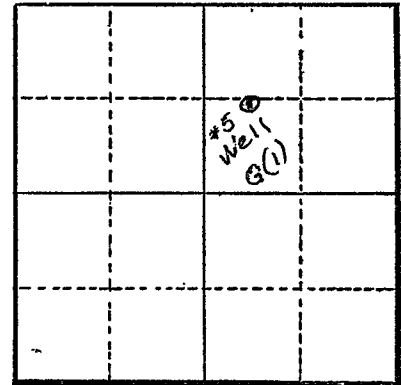

Section 17

Altitude at well 340 ft.

TYPE OF WELL: Driven Date Constructed 1955

Depth drilled 22 ft. Depth cased 22 ft.

CASING RECORD:

4 inch

FINISH:

AQUIFERS:

WATER LEVEL:

14 ft.

PUMPING EQUIPMENT: Type Gardner-Denver 3 in. H.P. Gas
Capacity 400 G.P.M.

WELL TESTS:

Drawdown ft. after hours G.P.M.
Drawdown ft. after hours G.P.M.

USE OF WATER Irrigation Temp. °F., 19

SOURCE OF INFORMATION G.R. Record

DRILLER or DIGGER

ADDITIONAL DATA:

Log N.A. Water Level Measurements Chemical Analysis Aquifer Test

REMARKS:

Irrigation of 25 acres.