

STATE ENGINEER
Salem, Oregon

LANE
6066

Well Record

STATE WELL NO. 15/LW-17K(1)
COUNTY Lane
APPLICATION NO. GR- 1010

GR- 976

OWNER: Walter & Andrea Nielsen

MAILING ADDRESS: Rt. 3


LOCATION OF WELL: Owner's No. #4

CITY AND STATE: Junction City, Oregon

NW 1/4 SE 1/4 Sec. 17 T. 15 S., R. 4 W., W.M.

Bearing and distance from section or subdivision

corner 30.8 ch. W. & 44 ch. S. from NE cor. Sec. 17.

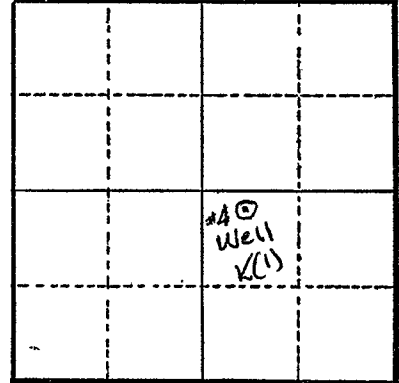

Section 17

Altitude at well 300 ft.

TYPE OF WELL: Driven Date Constructed 1952

Depth drilled 22 ft. Depth cased 22 ft.

CASING RECORD:

4 inch

FINISH:

AQUIFERS:

WATER LEVEL:

14 ft.

PUMPING EQUIPMENT: Type Cornell 2 1/2" H.P. 10

Capacity 300 G.P.M.

WELL TESTS:

Drawdown ft. after hours G.P.M.

Drawdown ft. after hours G.P.M.

USE OF WATER Irrigation Temp. °F., 19

SOURCE OF INFORMATION G.R. Record

DRILLER or DIGGER

ADDITIONAL DATA:

Log N.A. Water Level Measurements Chemical Analysis Aquifer Test

REMARKS:

Irrigation of 20 acres.