

STATE ENGINEER
Salem, Oregon

LANE
60068

Well Record

STATE WELL NO. 15/4W-17L(1)
COUNTY Lane
APPLICATION NO. GR-842


GR- 1110

OWNER: L. J. Bryson
MAILING ADDRESS: 102 Lingo Lane

LOCATION OF WELL: Owner's No. #3
CITY AND STATE: Junction City, Oregon

NE 1/4 SW 1/4 Sec. 17 T. 15 S., R. 4 W., W.M.

Bearing and distance from section or subdivision
corner 2600' E. & 2000' N. of SW cor. Sec. 17.

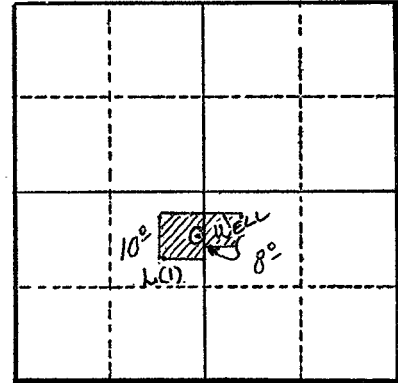

Section 17

Altitude at well 300 ft.

TYPE OF WELL: Driven Date Constructed 1950

Depth drilled 21 ft. Depth cased 21 ft.

CASING RECORD:

4 inch

FINISH:

AQUIFERS:

WATER LEVEL:

16 ft.

PUMPING EQUIPMENT: Type Bain-O-Flow 2 1/2 in. H.P. 10

Capacity G.P.M.

WELL TESTS:

Drawdown ft. after hours G.P.M.

Drawdown ft. after hours G.P.M.

USE OF WATER Irrigation Temp. °F., 19.

SOURCE OF INFORMATION G. R. Record

DRILLER or DIGGER

ADDITIONAL DATA:

Log N.A. Water Level Measurements Chemical Analysis Aquifer Test

REMARKS:

Irrigation of 19 acres.



Oregon Water Resources Department
 725 Summer Street NE, Suite A
 Salem Oregon 97301
 (503) 986-0900
 www.oregon.gov/owrd

Application for Well ID Number

RECEIVED

SEPT 24 2024

OWRD

Do not complete if the well already has a Well Identification Number.

I. OWNER INFORMATION

Current Owner Name (please print): Don and Carla Brown
 Mailing Address: 95796 Noraton Rd
 City, State, Zip: Junction City, OR 97448
 Mail Well ID to: SAME AS ABOVE In Care Of (C/O)
 Name & Address: Tosh Dickenson, Willamette Properties Group
 City, State, Zip: 93244 Hwy 99S, Junction City OR 97448

II. WELL LOCATION INFORMATION (Please fill out as completely as possible)

Township: 15 S (North / South) Range: 4 W (East / West) Section: 17 NE 1/4 of the SW 1/4
 Tax Lot (usually last 3-5 numbers of Tax Map #): 2200 County Lane
 GPS Coordinates: 44.263968 -123.199258
 Street Address of Well, City: 95796 Noraton Rd, Junction City OR 97448
 If the property had a different street address in the past: _____

III. GENERAL WELL INFORMATION (Please fill out as completely as possible, AND attach copy of Well Report, if available)

Use of Well (domestic, irrigation, commercial, industrial, monitoring): irrigation
 Date Well Constructed (or property built): 1950 Total Well Depth: 21' Casing Diameter: 4"
 Owner at time the well was constructed (if known): LJ Bryson Well Report # (if known): LANE 6068
 Other Information: WR Claim GR-842 (North well)

SUBMITTED BY (please print): Tosh Dickenson
 PHONE: 541-844-5687 EMAIL &/or FAX: tosh@wpgoregon.com

To send the completed application, you may MAIL it to: Oregon Water Resources Dept. 725 Summer St NE, Suite A, Salem, Oregon 97301.
 Or EMAIL the completed PDF form to: Ladeena.K.Ashley@water.oregon.gov, or FAX it to: (503) 986-0902.

For Official Use Only by the Oregon Water Resources Department:

Received Date: <u>9-24-2024</u>	Well Report Number: <u>LANE 6068</u>	Well Identification #: <u>L-156018</u>
------------------------------------	---	---