

STATE ENGINEER
Salem, Oregon

LANE 6069

6069

Well Record

STATE WELL NO. 15/4W-17M
COUNTY LANE
APPLICATION NO. GR-2588

OWNER: Isaac R. Howard

MAILING

ADDRESS: Junction City,


LOCATION OF WELL: Owner's No. #2

CITY AND

STATE: Oregon

NW 1/4 SW 1/4 Sec. 17 T. 15N 4E W.M.

Bearing and distance from section or subdivision
corner 2270' N. & 575' E.

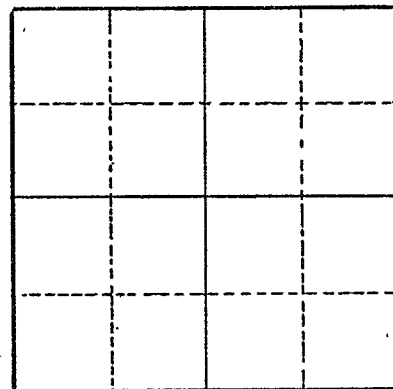

Section

Altitude at well

TYPE OF WELL: Driven Date Constructed 1950

Depth drilled 24 Depth cased 24

CASING RECORD:

6-inch

FINISH:

Standard perforations from 21 to 24

AQUIFERS:

Loam, sand & gravel

WATER LEVEL:

12-feet

PUMPING EQUIPMENT: Type Pacific Centrifugal H.P. 20
Capacity 200 G.P.M.

WELL TESTS:

Drawdown 2 ft. after hours Pumping 250 G.P.M.

Drawdown ft. after hours G.P.M.

USE OF WATER Irrigation Temp. °F., 19

SOURCE OF INFORMATION GR-2455

DRILLER or DIGGER

ADDITIONAL DATA:

Log X Water Level Measurements Chemical Analysis Aquifer Test

REMARKS:

Loam

Sand & gravel

4 20

20 0



Oregon Water Resources Department
725 Summer Street NE, Suite A
Salem Oregon 97301
(503) 986-0900
www.wrd.state.or.us

Application for Well ID Number

RECEIVED

JUL 05 2017

Do not complete if the well already has a Well Identification Number.

I. OWNER INFORMATION

WATER RESOURCES DEPT
SALEM, OREGON

Current Owner Name (please print): June Elias

Mailing Address: 38825 Charlesworth Dr

City, State, Zip: Cathedral City, CA 92234

Mail Well ID Tag to: ☐ SAME AS ABOVE ☒ In Care Of (C/O)

Name & Address: Willamette Properties Group 225 W 6th Ave

City, State, Zip: Junction City, OR 97448

II. WELL LOCATION INFORMATION (Please fill out as completely as possible)

Township: 15S (North / South) Range: 4W (East / West) Section: 17 NW 1/4 of the SW 1/4

Tax Lot (usually last 3-5 numbers of Tax Map #): 01701 County Lane

GPS Coordinates:

Street Address of Well, City: 95829 Howard Ln, Junction City OR 97446

If the property had a different street address in the past: 450 Howard Lane, Junction City

III. GENERAL WELL INFORMATION (Please fill out as completely as possible, AND attach copy of Well Log, if available)

Use of Well (domestic, irrigation, commercial, industrial, monitoring): irrigation

Date Well Constructed (or property built): 1950 Total Well Depth: 24 Casing Diameter: 6

Owner at time the well was constructed (if known): Isaac Howard Well Log # (if known): LANE 6069

Other Information: GR-2588

SUBMITTED BY (please print): Lisanne Dickenson

PHONE: 541-998-3378

EMAIL &/or FAX: lisanne@wpgoregon.com

Send application to: Oregon Water Resources Department 725 Summer St NE, Suite A, Salem, Oregon 97301; or fax to (503) 986-0902.
Applications are processed in the order they are received, and Well ID Numbers are mailed within 4-5 business days.

For Official Use Only by the Oregon Water Resources Department:

Received Date:

7-5-17

Well Log Number:

LANE 6069

Well Identification #:

L-127115